


LEGEND

- EXISTING GROUND -----
- FUTURE CONSTRUCTION -----
- PROPOSED UTILITY POLE (BY OTHERS) |

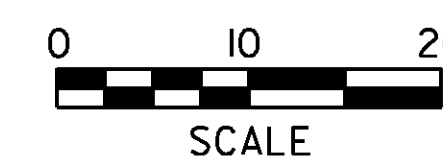

PROJECT NAME: EAST MONTPELIER	PLOT DATE: 5/26/2016
PROJECT NUMBER: BF EWP2(1)	DRAWN BY: C. GENDRON
FILE NAME: XS - ER.dgn	CHECKED BY: G. GOYETTE
PROJECT LEADER: T. KNIGHT	SHEET 33 OF 42
DESIGNED BY: K. RICHARDSON	
UTILITY CROSS SECTIONS - UXS 1	