


WORK ZONE #5A NOTES

OBJECTIVE: THE PURPOSE OF WORK ZONE #5A IS TO PROTECT THE TRAVELING PUBLIC FROM CONSTRUCTION HAZARDS STAGED WITHIN THE ROADWAY CLEAR ZONE THAT ARE NECESSARY FOR THE EXCAVATION OF EARTH IN FRONT OF THE PROPOSED RETAINING WALL. THE ROADWAY WILL BE REDUCED TO ONE-WAY ALTERNATING TRAFFIC DURING OFF-PEAK HOURS ONLY.

THIS TRAFFIC CONTROL PACKAGE WILL BE IMPLEMENTED PRIOR TO EACH WORK SHIFT AND WILL BE COMPLETELY REMOVED PRIOR TO HOURS OF PEAK TRAFFIC. UTO S AND FLAGGERS WILL BE PRESENT AT ALL TIMES THAT THE TRAFFIC CONTROL PACKAGE IS ERECTED, REMOVED AND IN SERVICE.

CONTRACTOR WILL PROVIDE STAFF TO ESCORT PEDESTRIANS THROUGH THE WORKZONE. REFER TO NOTE 15 ON SHEET 33.

WORK ZONE #5A

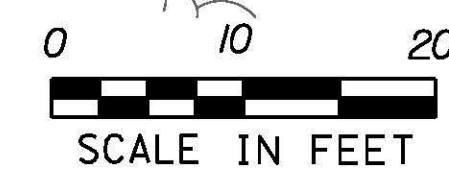

PROJECT NAME:	EAST MONTEPELIER	PLOT DATE:	5/26/2016
PROJECT NUMBER:	BF EWP2(1)	DRAWN BY:	P. ARMATA
FILE NAME:	s98b252bdrtcp - ER.dgn	CHECKED BY:	T. KNIGHT
DESIGNED BY:	K. RICHARDSON	TRAFFIC CONTROL PLAN - WORK ZONE #5A	SHEET 41 OF 42

