

BLOCK LEGEND & QUANTITIES



HGC	HALF GARDEN CORNER BLOCK	4
GC	GARDEN CORNER BLOCK	2
T	TOP BLOCK	26
MC	MIDDLE CORNER BLOCK	7
BC	BOTTOM CORNER BLOCK	2
H41M	HALF 41" MIDDLE BLOCK	1
41M	41" MIDDLE BLOCK	97
41MN	41" MIDDLE "NARROW" BLOCK	3
H41B	HALF 41" BOTTOM BLOCK	2
41B	41" BOTTOM BLOCK	8
60M	60" MIDDLE BLOCK	8
60B	60" BOTTOM BLOCK	15

NOTE: IF THE FIELD CONDITIONS INDICATE THE GRADE AT THE BASE AND/OR TOP OF THE WALL TO BE DIFFERENT FROM THAT SHOWN ON THESE PLANS, THE DESIGN ENGINEER SHALL BE CONTACTED TO VERIFY CHANGES TO THE WALL BASE COURSE AND/OR TOP OF WALL ELEVATION. THE GRADES SHOWN ON THIS PLAN ARE BASED ON THE WALL PLAN & PROFILE (SHEET 12) PREPARED BY STANTEC, PLOT DATE 5/26/16.

Please provide additional information on wall texture, integral color and stained color for approval before

APPROVED: Approval of drawing and/or procedure indicated in accordance with the information provided and does not release the Contractor/ Fabricator of compliance with all specifications and code requirements.	
APPROVED AS NOTED	
REVIEW AND REVISIONS	
NOT REVIEWED	
Date: 9/9/16	
Signature: TEK	
<small>This review by Stantec Consulting Services Inc. is for the sole purpose of maintaining compliance with the general design concept. This review shall not mean that Stantec Consulting Services Inc. approves the design, is liable for the design, or assumes any responsibility for which shall remain with the Contractor. Subsequent errors and omissions shall not release the Contractor of his or her responsibility for the same. The Contractor shall remain responsible for the design and construction of the project and shall be responsible for the coordination and execution of the project. The Contractor shall be responsible for the coordination and execution of the project and shall be responsible for the coordination and execution of the project.</small>	

IT IS THE RESPONSIBILITY OF THE INSTALLER TO REVIEW THE NOTES AND DETAILS ON ALL SHEETS OF THIS PLAN SET

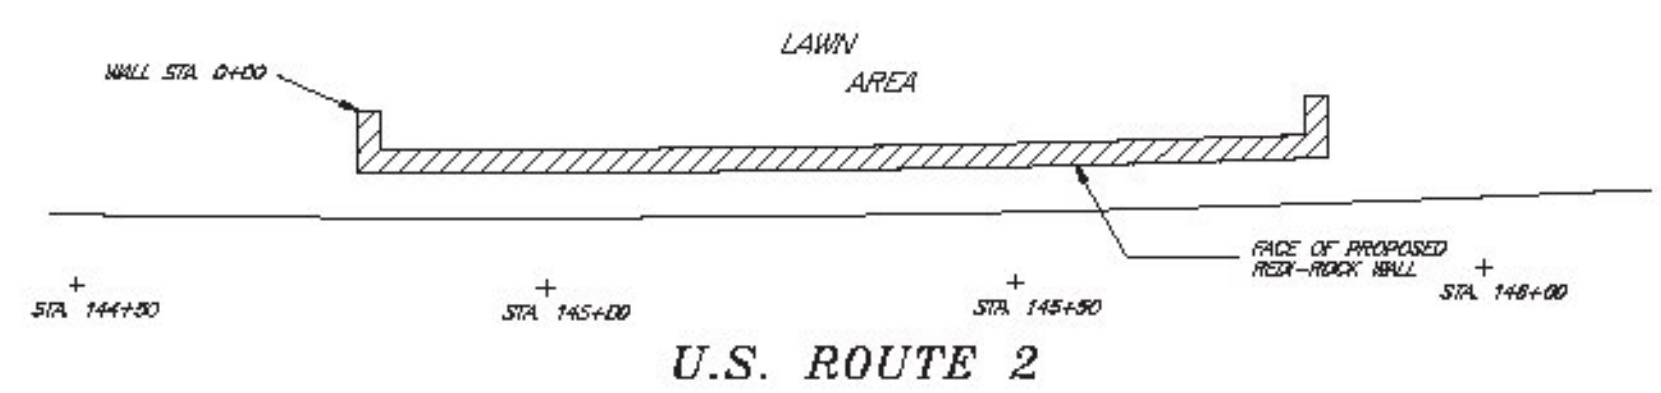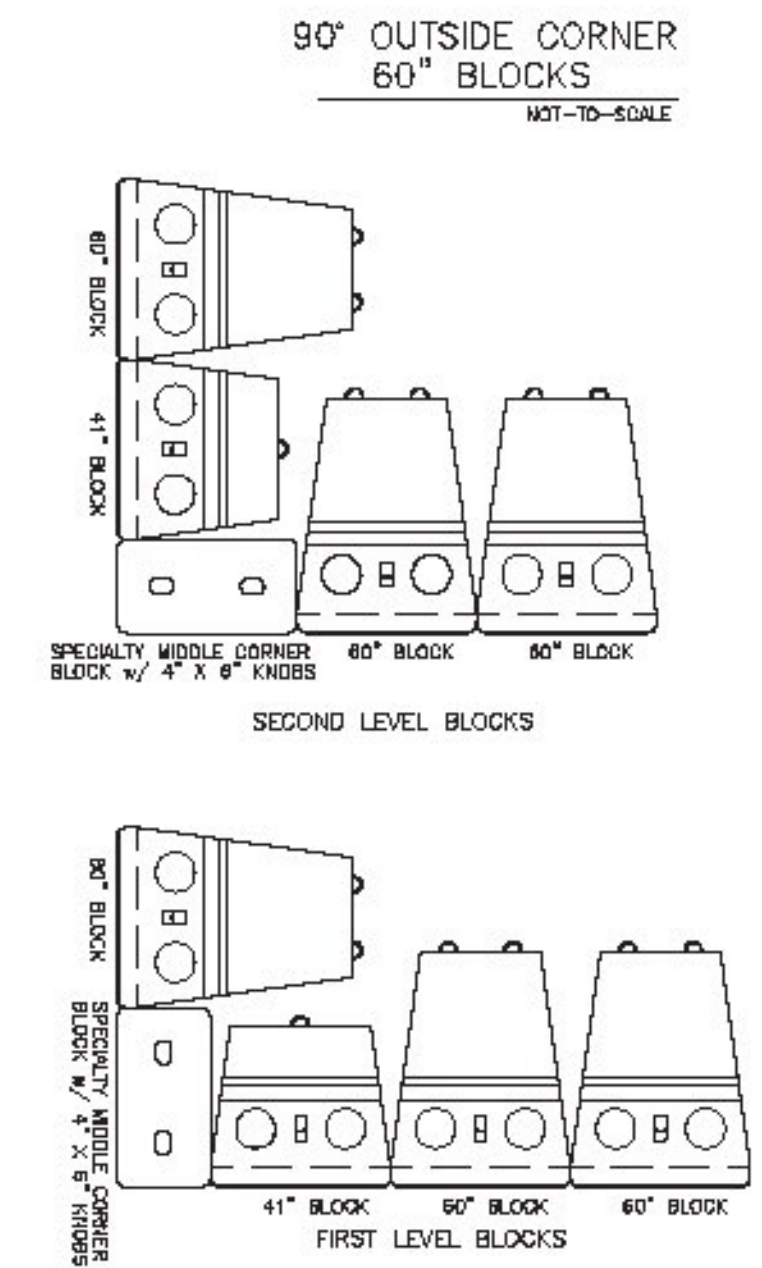

NOTE: THIS DRAWING WAS PREPARED FOR USE WITH RED-ROCK (TM) RETAINING WALL SYSTEMS. CONTACT RED-ROCK WALLS OF NEW ENGLAND AT (803) 883-1000.

ERIC MERLUZZI, P.E.	
184 ROWENTOWN ROAD, WENTWORTH, NH 03222	
PHONE: (803) 786-2761	E-MAIL: em32@earthlink.net
CLIENT: RED-ROCK WALLS OF NEW ENGLAND 9 NEEDS MILL ROAD, NEWPORT, NH 03773	
PROJECT: EAST MONTPELIER BRP 037-1(7) US ROUTE 2, EAST MONTPELIER, VT	
SHEET TITLE: RETAINING WALL DESIGN SHEET 2	
DATE: AUGUST 30, 2016	PROJECT NO.: 2016-050

SHEET 2 OF 2