

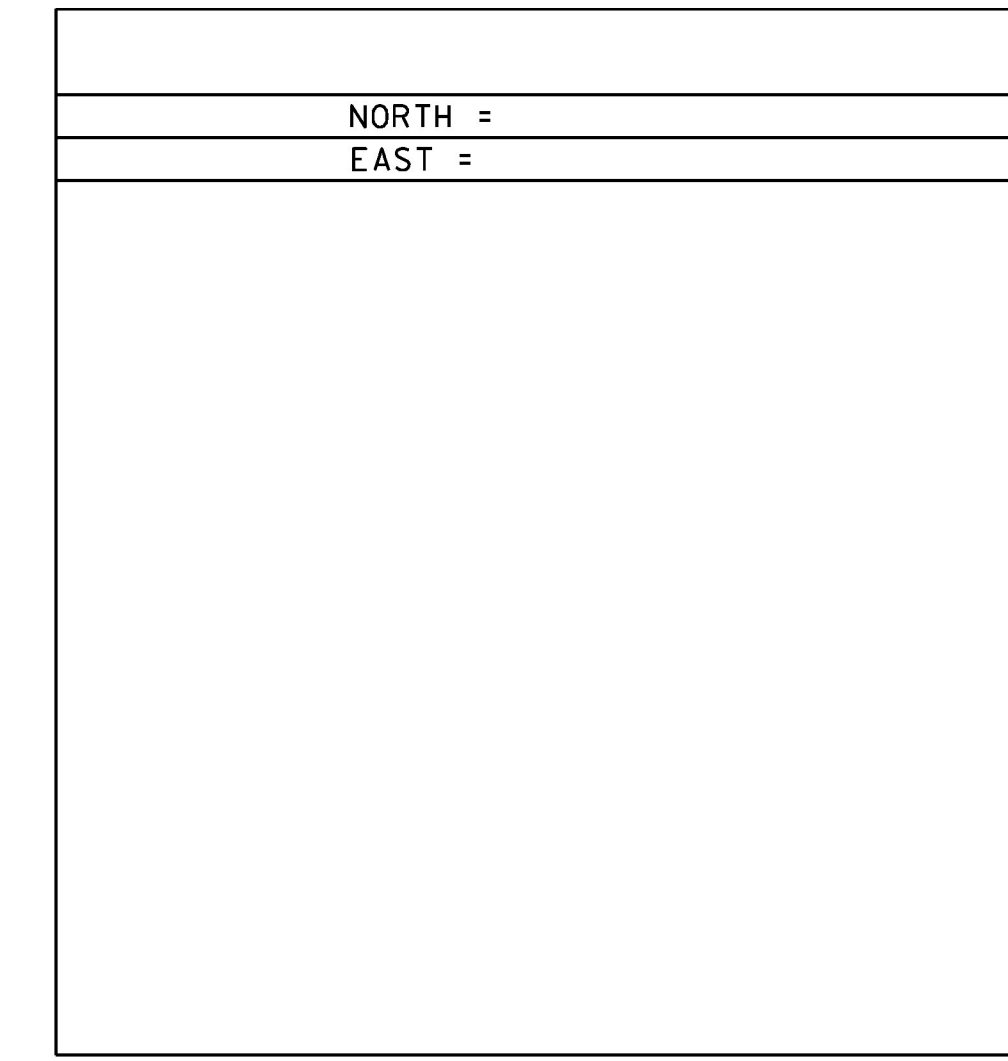
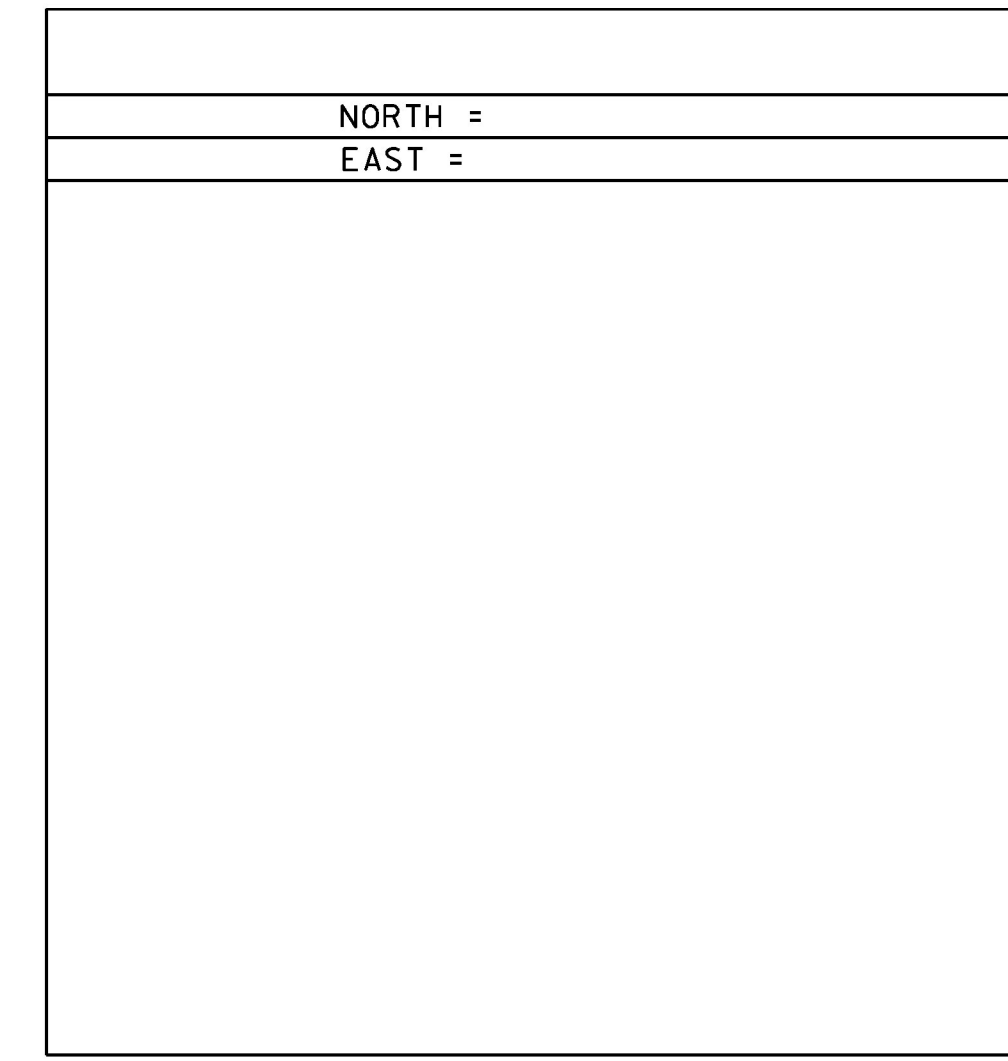
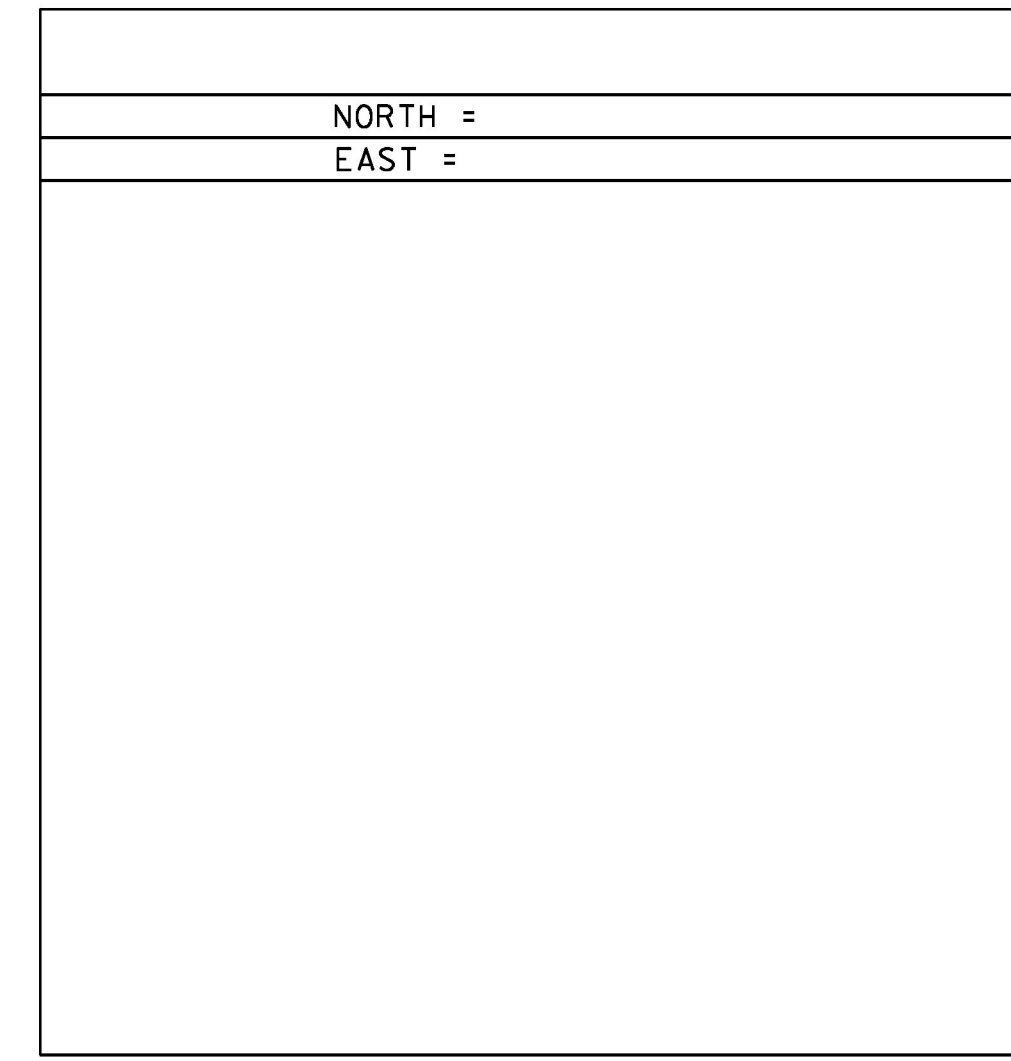
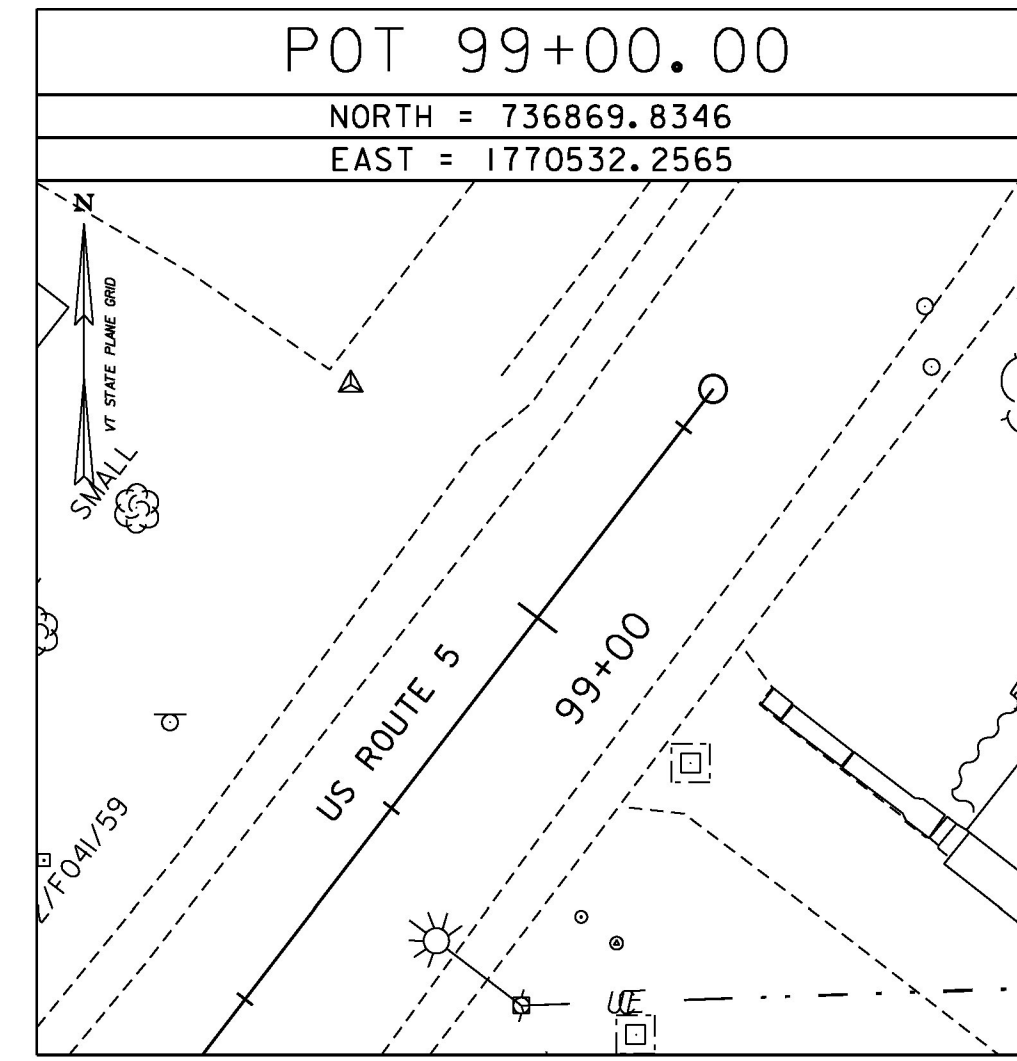
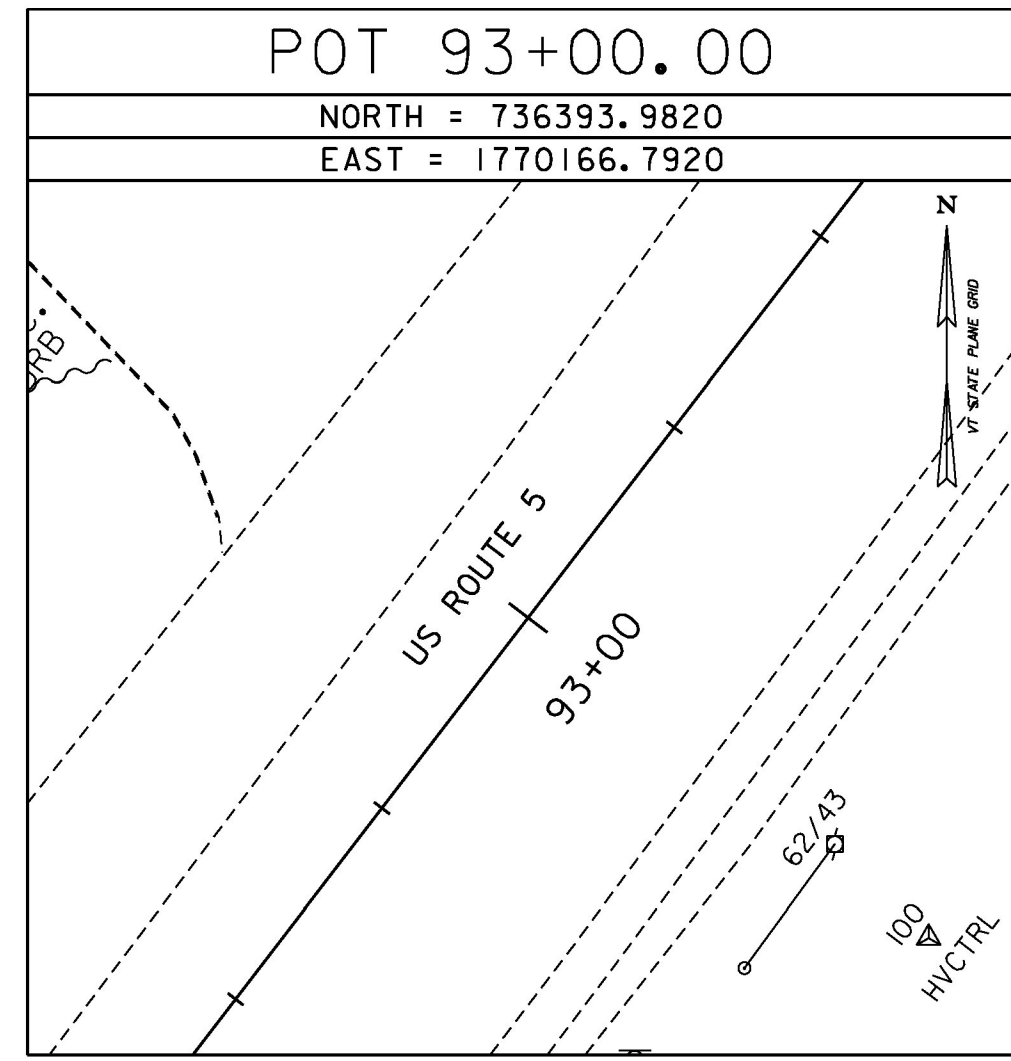
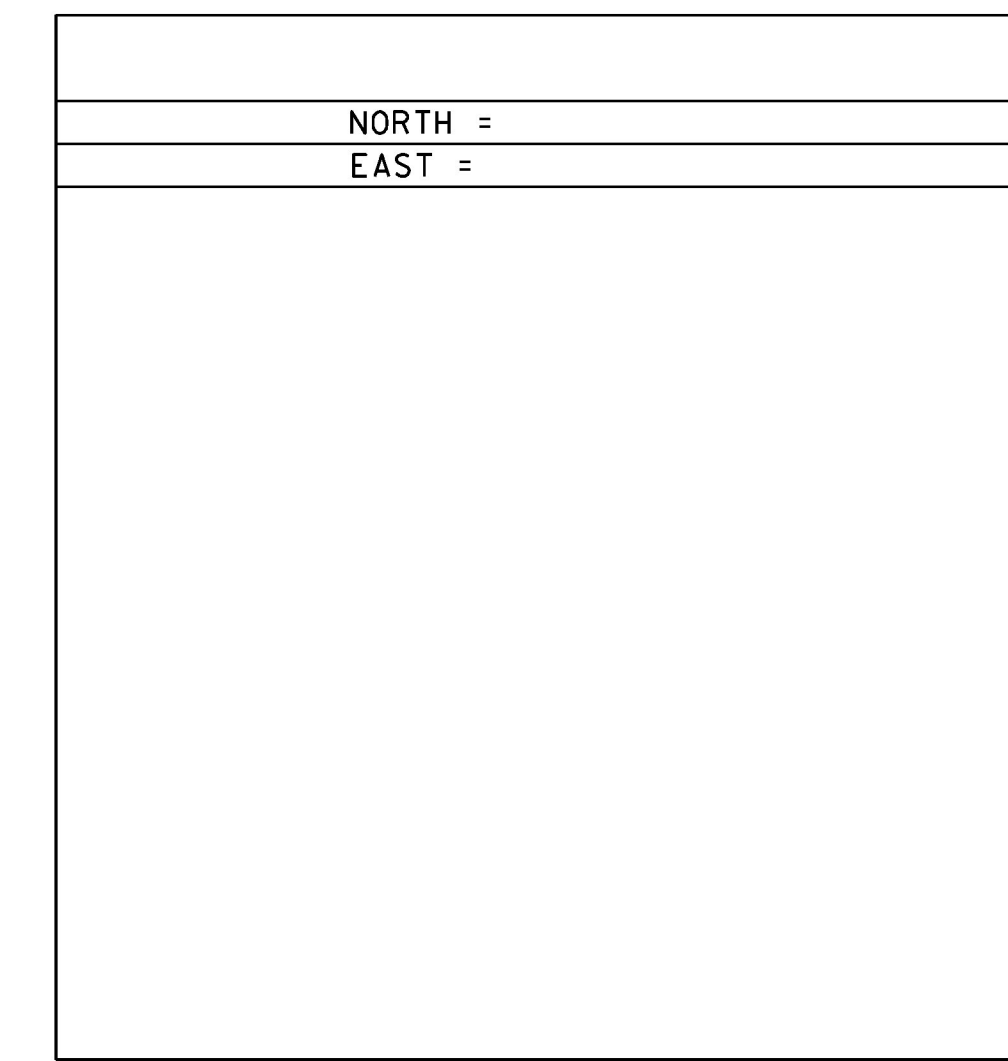
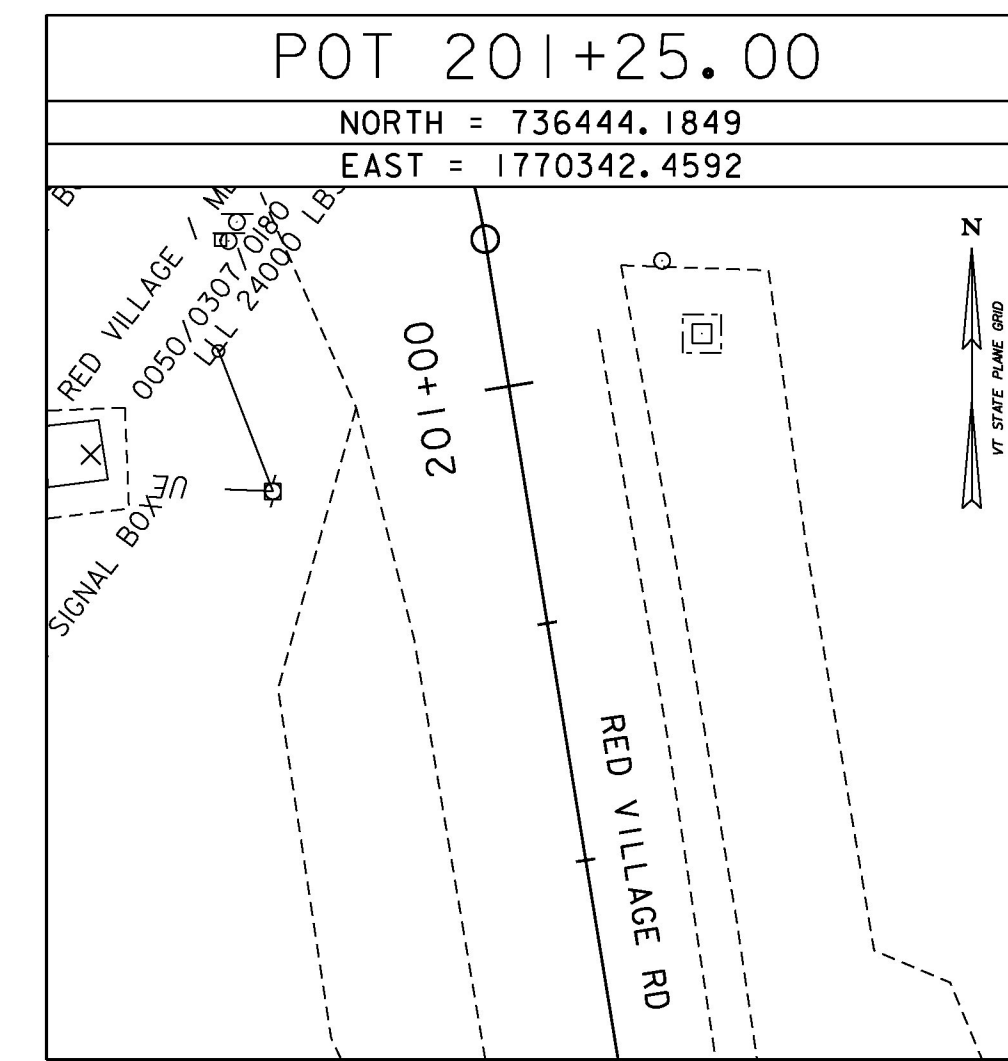
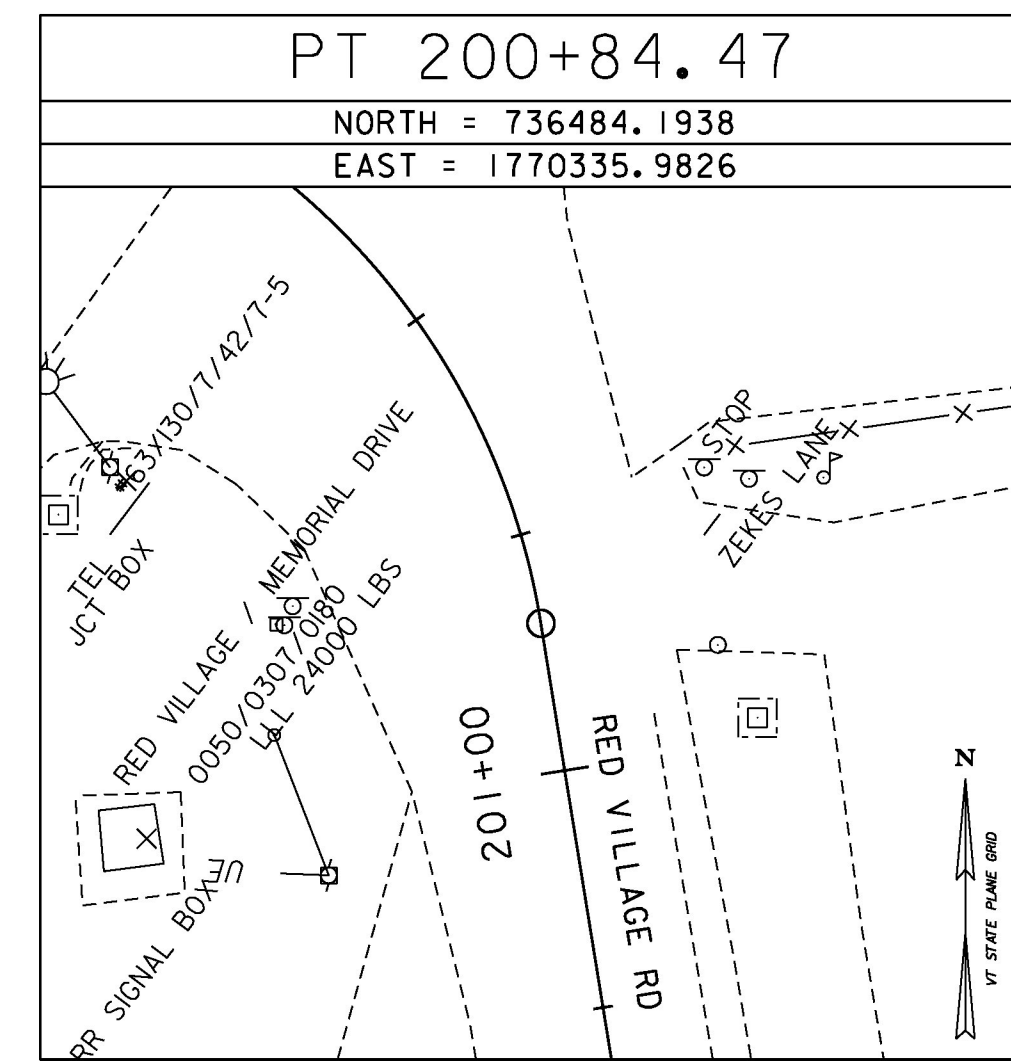


ALIGNMENT TIES

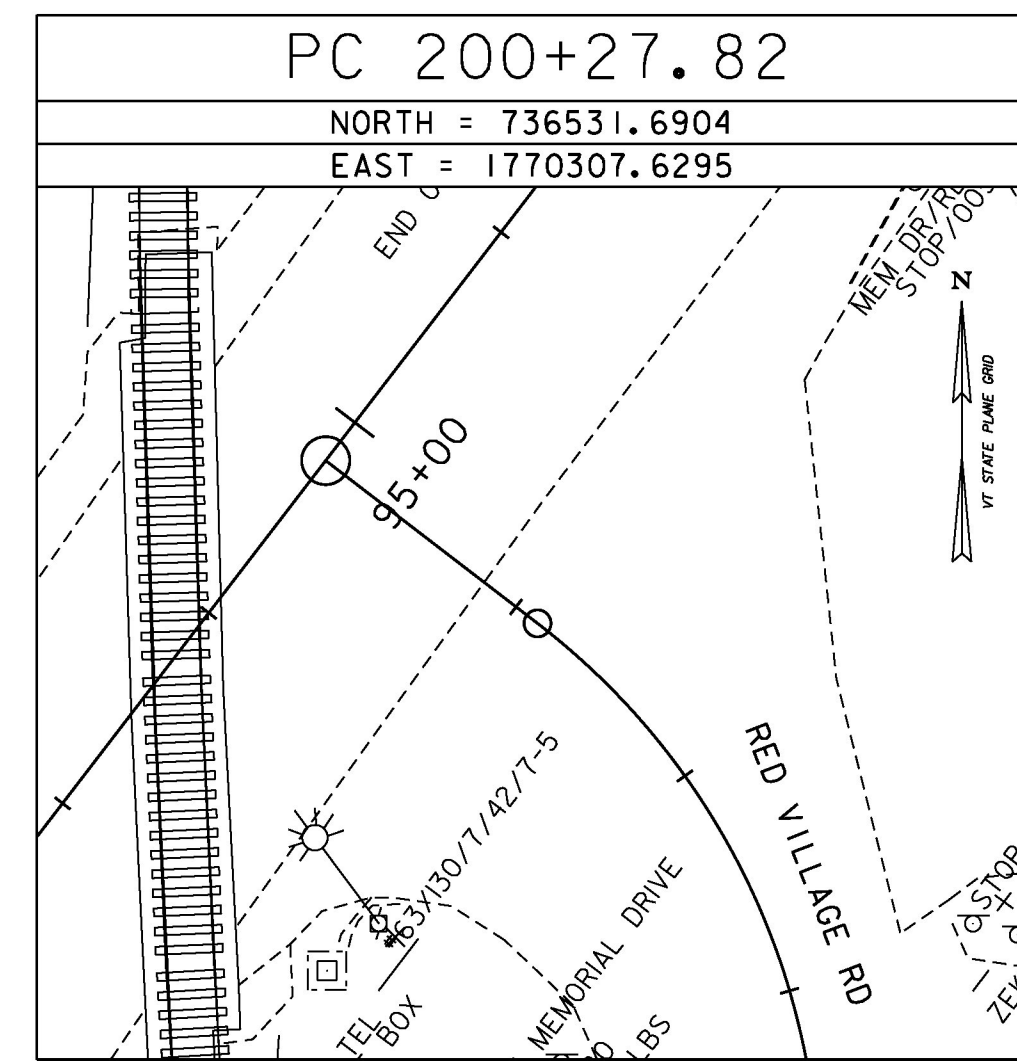

ALIGNMENT TIES

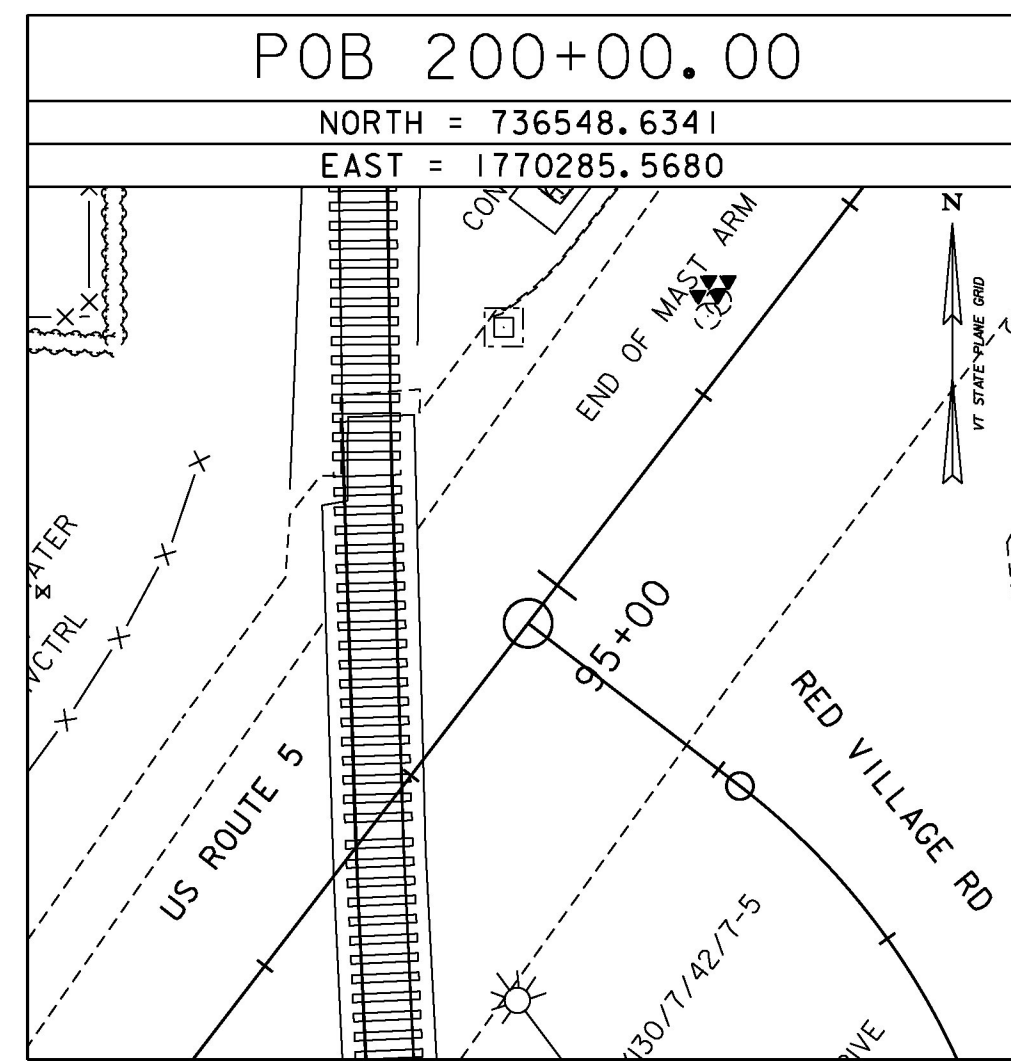

PROJECT NAME: LYNDON
 PROJECT NUMBER: STPG SGNL(48)

FILE NAME: z16d054t1.dgn
 PROJECT LEADER: P. SHEDD
 DESIGNED BY: M. HALEY
 TIE SHEET 2

PLOT DATE: 12/13/2016
 DRAWN BY: S. GOODWIN
 CHECKED BY: P. SHEDD
 SHEET 4 OF 18

