



94+13

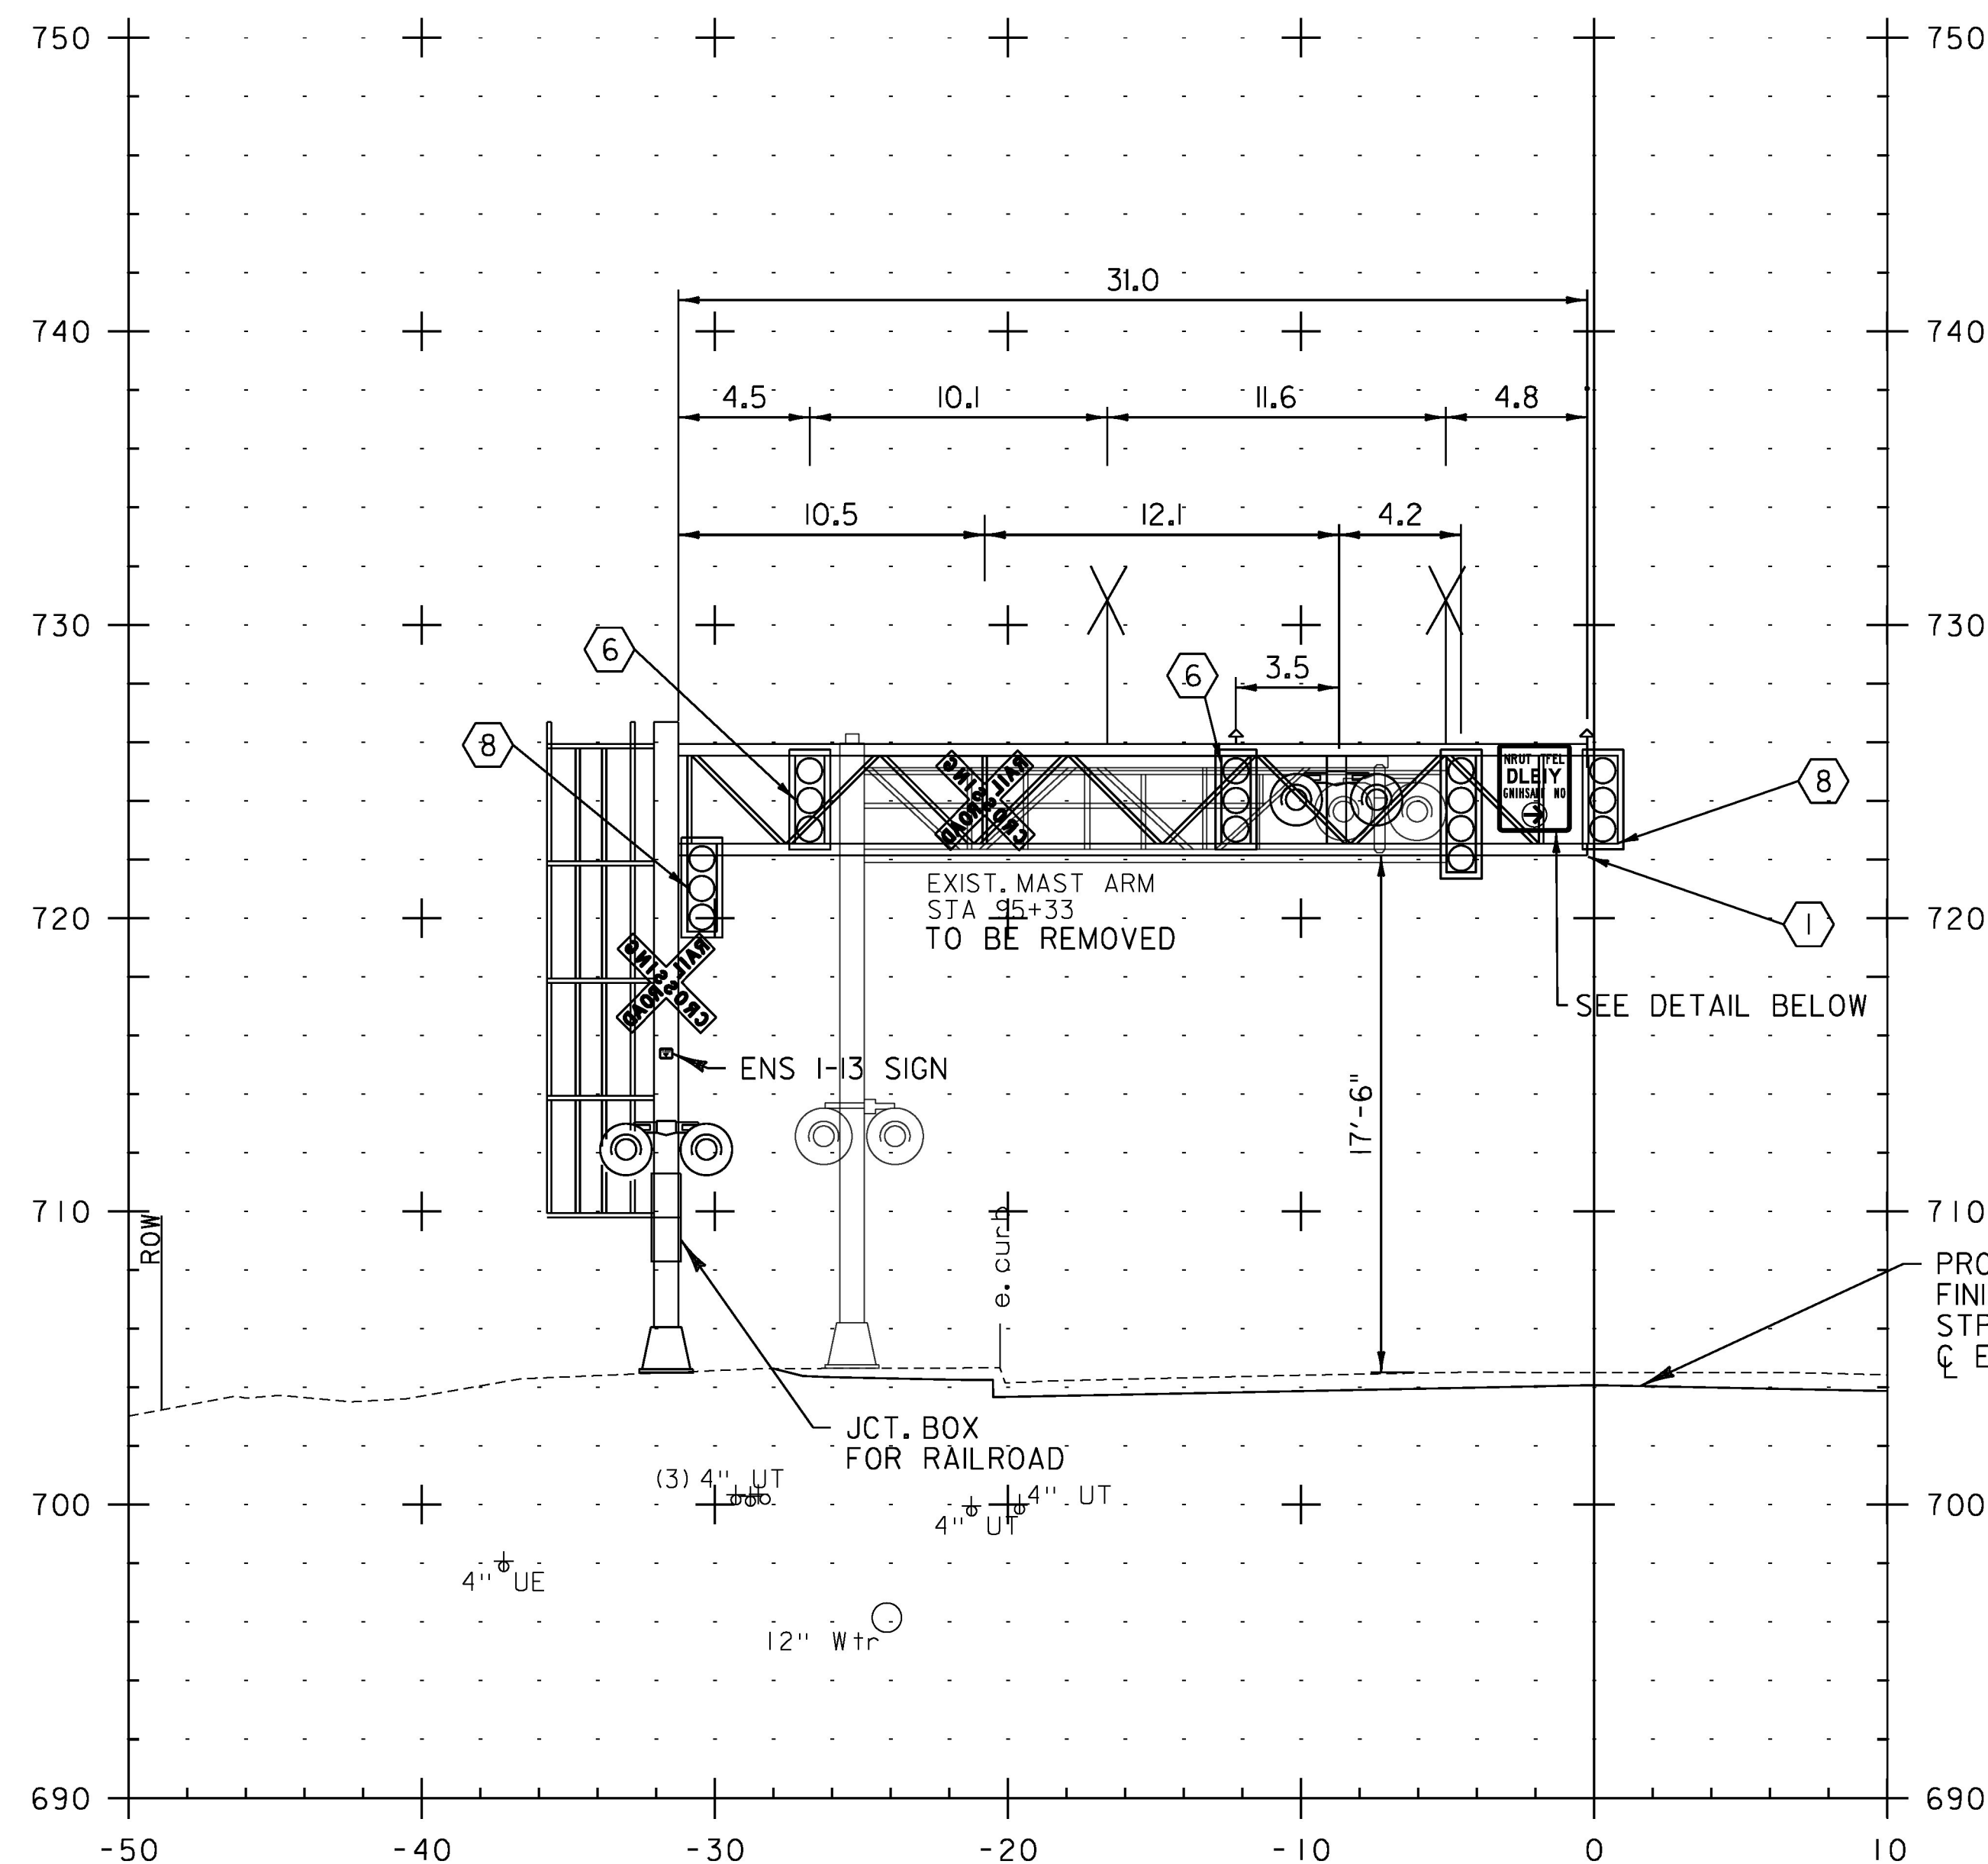

95+56

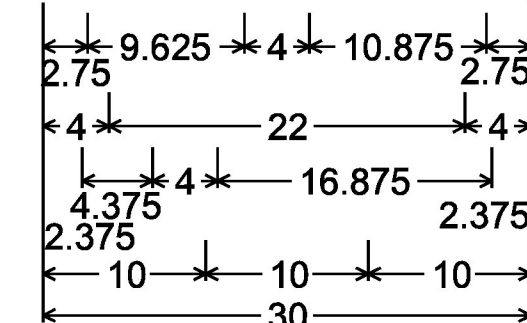

1.875" Radius, 0.750" Border, 0.500" Indent, Black on White;
 [LEFT TURN] C 2K;
 [YIELD] D 2K;
 [ON FLASHING] B 2K;
 FYA symbol;

NEW	LEGEND
	SIGNAL HEAD
	RADAR
	SIGNAL PHASE

NOTE
 DRILLED SHAFT FOUNDATIONS ARE REQUIRED FOR DUAL USE OVERHEAD STRUCTURES.

PROJECT NAME: LYNDON
 PROJECT NUMBER: STPG SGNL(48)

FILE NAME: z16d054xs.dgn
 PROJECT LEADER: P. SHEDD
 DESIGNED BY: P. KONIECZKA
 MAST ARM CROSS SECTIONS

PLOT DATE: 12/13/2016
 DRAWN BY: S. GOODWIN
 CHECKED BY: L. GREER
 SHEET 18 OF 18

