



PROPRIETARY & CONFIDENTIAL DATA

INFORMATION CONTAINED IN THIS DRAWING IS PROPRIETARY & CONFIDENTIAL DATA BY GE TRANSPORTATION SYSTEMS - GLOBAL SIGNALING AND IS SUBMITTED FOR THE SOLE PURPOSE OF MAINTAINING GE TRANSPORTATION SYSTEMS - GLOBAL SIGNALING EQUIPMENT. ANY UNAUTHORIZED USE OR DISTRIBUTION OF THIS DRAWING IS STRICTLY PROHIBITED.
©2001 GE TRANSPORTATION SYSTEMS - GLOBAL SIGNALING

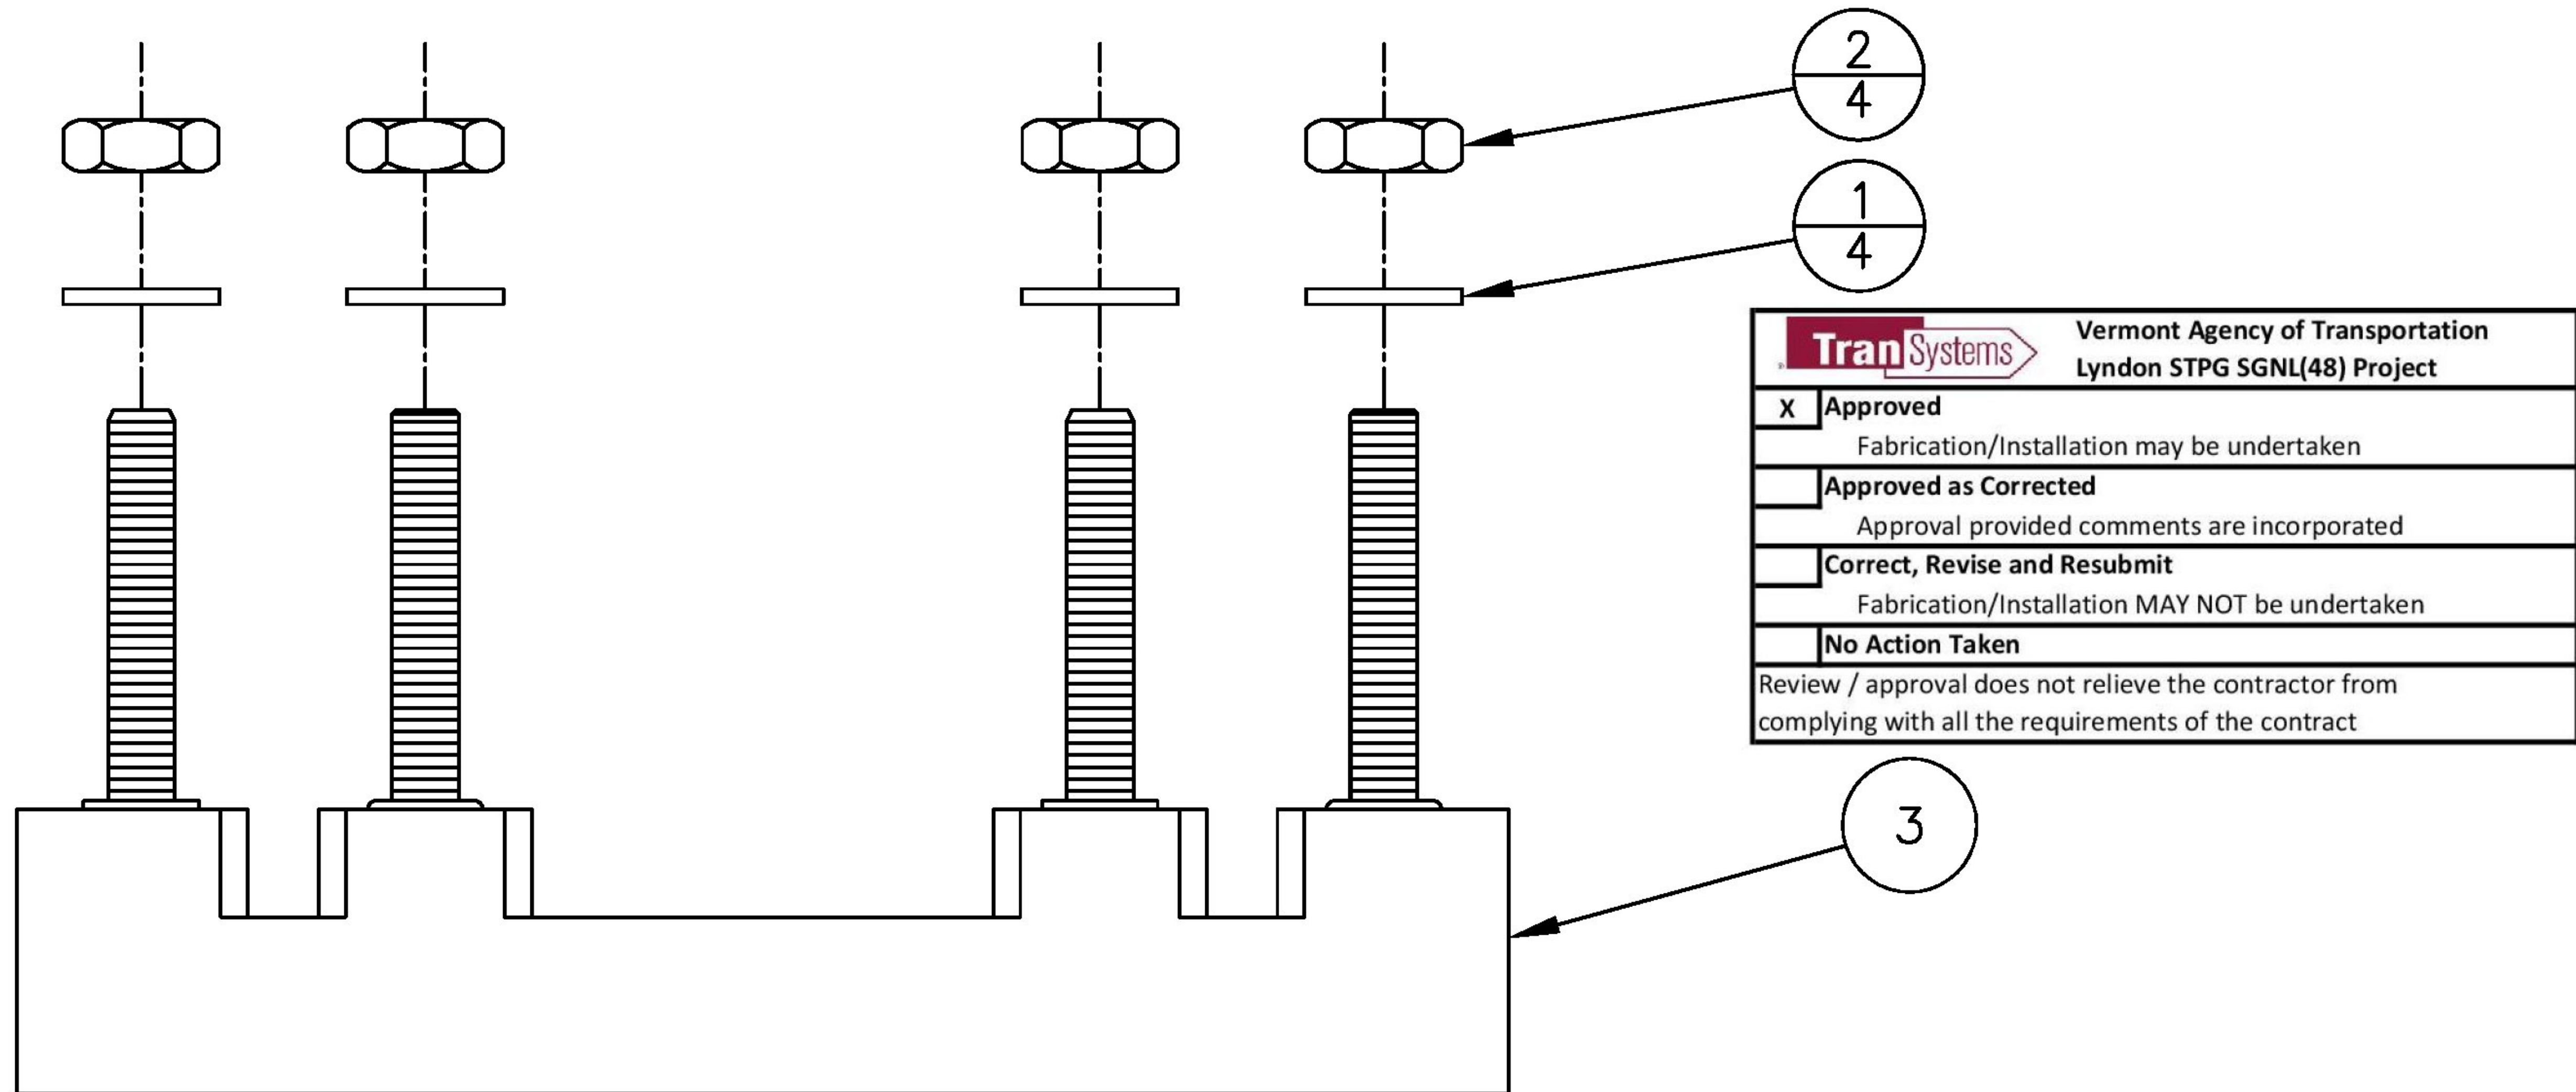

NOTES:

1. TORQUE NUTS (DIN 2) TO 60 IN LBS.

UNLESS OTHERWISE SPECIFIED DIMENSIONS ARE IN INCHES. DIMENSIONS IN [] ARE MILLIMETERS.					DRAWN BY SUNIL UDDARAJU		DATE 08/01/05		 GE TRANSPORTATION SYSTEMS GLOBAL SIGNALING ARGO & DILLINGHAM, GRAIN VALLEY, MO 64029 U.S.A.
.XX ± NA FRACTIONS ± NA .XXX ± NA ANGLES ± NA					APPROVED WAYNE WOMACK		DATE 08/05		
REV	CHANGE NO.	DATE	BY	APVD	TITLE ASSEMBLY 4 POST ARRESTOR BASE SIZE SCALE DRAWING NO. SHEET REV. A NTS 203032-000 1 OF 1 AAO				
AA0	90102800	08/05	SU	WW					
PRODUCT:									