



" " 12" x 27"
 " " 12" x 38"

GETSGS # 040231-001
 GETSGS # 040231-002

Battery Trays

1 - Battery Trays shall be used on top of shelves or on floor within signal enclosure and not freely supporting equipment

Tran Systems		Vermont Agency of Transportation Lyndon STPG SGNL(48) Project
<input type="checkbox"/>	Approved	
Fabrication/Installation may be undertaken		
<input checked="" type="checkbox"/>	Approved as Corrected	1
Approval provided comments are incorporated		
<input type="checkbox"/>	Correct, Revise and Resubmit	
Fabrication/Installation MAY NOT be undertaken		
<input type="checkbox"/>	No Action Taken	
Review / approval does not relieve the contractor from complying with all the requirements of the contract		

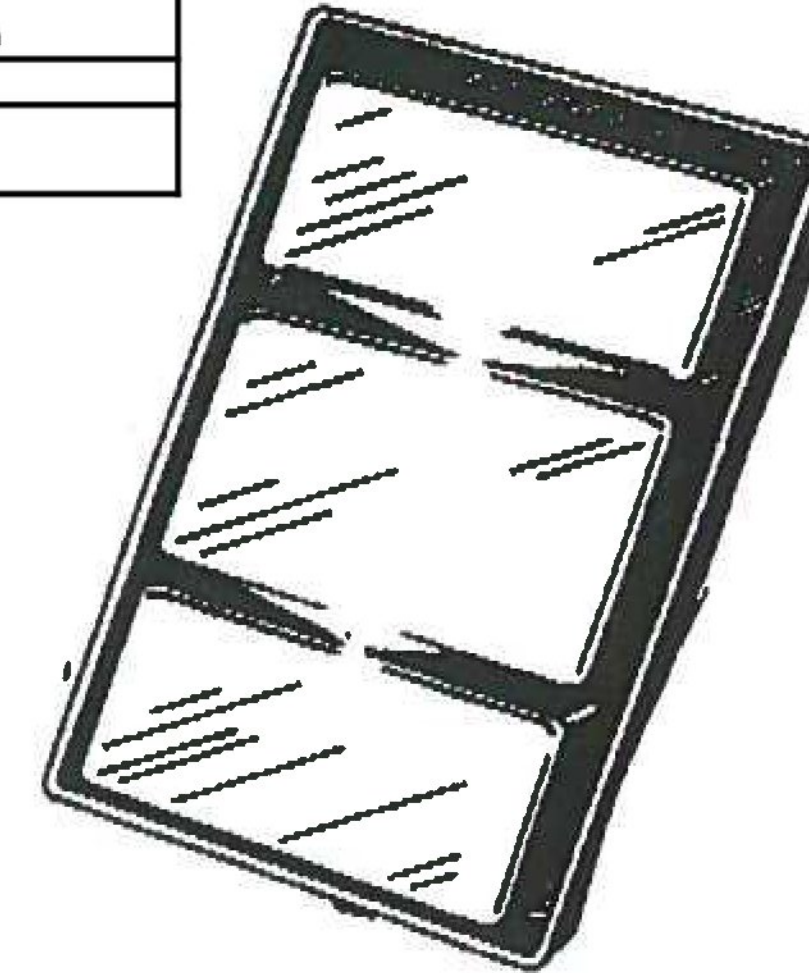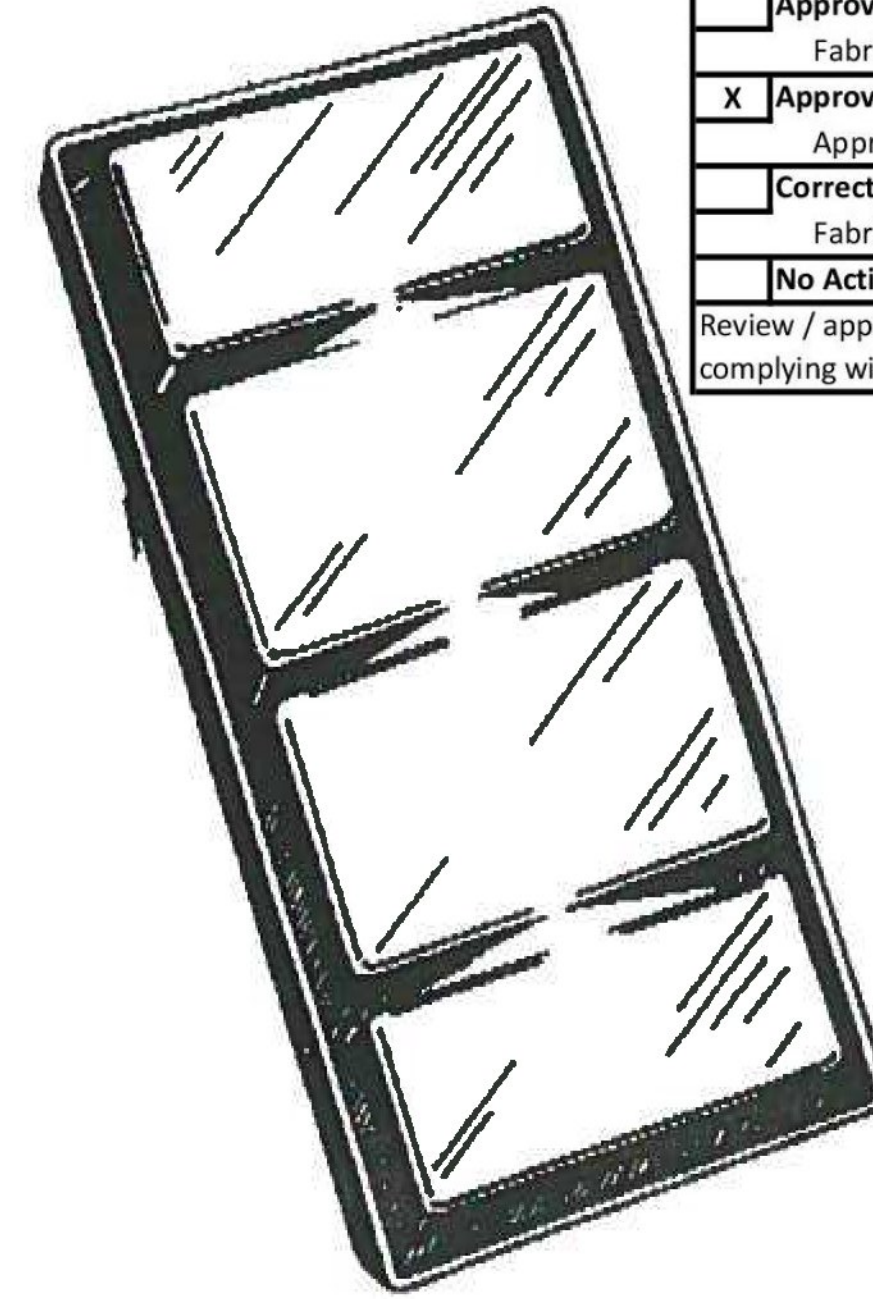


High Density Polyethylene

FIBER-CO PN: GETSGS PN:

12" Wide x 24" Long	82687-1-P	040231-000
12" Wide x 27" Long	82687-2-P	040231-001
12" Wide x 38" Long	82687-3-P	040231-002
13" Wide x 38" Long		

No Ground * Protect Battery Boxes and Floors For Special Applications, Custom Sizes are Available.
 For Further Information, Call or Write:

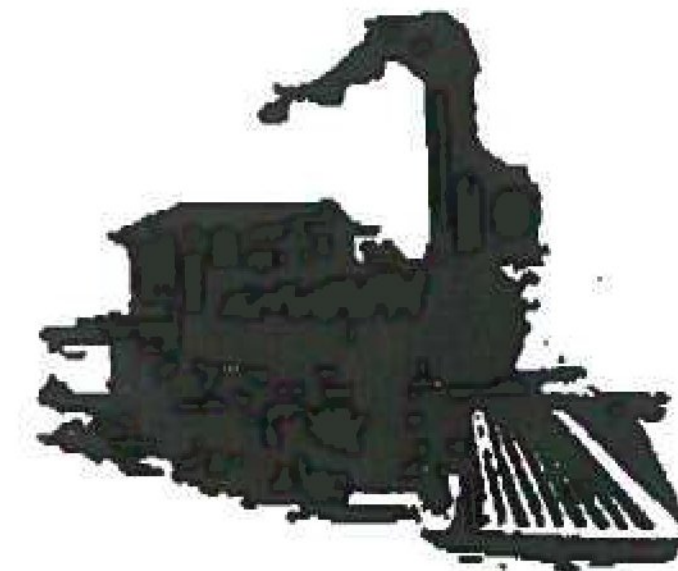

F I B E R - C O , I N C .

145 US Hwy 441 S.E.
 Okeechobee, FL 34974
 Phone: (863) 763-1927
 Fax: (863) 763-1359
 E-mail: fibercofl@earthlink.net

