

This Drawing, which contains proprietary information is the property of General Electric Company. It shall not be reproduced in any manner nor disclosed to third parties without written permission of General Electric Company.

HARMON PART NUMBERING

HPN	VOLTAGE (NOMINAL)	TYPE OF SERVICE	CLAMPING VOLTAGE	MCOV	TOTAL PEAK SURGE CURRENT	SURGE ENERGY PER PHASE (MIN)	RESPONSE TIME	RELATIVE HUMIDITY	DESCRIPTION	TERMINATION	DIMENSIONS / WIRING DIAGRAM	NOTES
-000	240 VAC RMS L-L	3-WIRE, SINGLE PHASE, 50/60 HZ	260 VOLTS AT 1 mA L-N	NOT AVAILABLE	---	16667 JOULES (SEE NOTE 1)	6 ns	100%	FUSED SURGE PROTECTOR WITH INDICATORS	LEAD WIRES 14 AWG 18" LONG MIN.	SEE FIGURES 1 AND 2	---
-001	120/240 VAC 50/60 HZ 50-100 A SERVICE	SINGLE PHASE WYE; 3 WIRE + GROUND CONNECTION	NOT AVAILABLE	275 VAC L-L; 150 VAC L-G, L-N, N-G	117,000 A	1,800 JOULES	1 ns	0-97% NON-CONDENSING	PRIMARY SURGE PROTECTOR WITH INDICATORS	SCREW TERMINALS, ACCEPTS 10AWG AND SMALLER STRANDED WIRE.	SEE FIGURE 3 (NEMA TYPE 12 ENCLOSURE)	NOT FOR NEW DESIGN USE -003
-002	120/240 VAC 50/60 HZ 50-100 A SERVICE	SINGLE PHASE WYE; 3 WIRE + GROUND CONNECTION	NOT AVAILABLE	275 VAC L-L; 150 VAC L-G, L-N, N-G	117,000 A	1,800 JOULES	1 ns	0-97% NON-CONDENSING	PRIMARY SURGE PROTECTOR WITH INDICATORS, INTERNALLY FUSED	PRESSURE TYPE, ACCEPTS 8AWG AND SMALLER STRANDED WIRE.	SEE FIGURES 4 AND 5 (NEMA TYPE 12 ENCLOSURE)	NOT FOR NEW DESIGN USE -004
-003	120/240 VAC 50/60 HZ 300 A SERVICE	SPLIT PHASE WYE; 3 WIRE + GROUND CONNECTION	---	275 VAC L-L; 150 VAC L-G, L-N, N-G	120,000 A (8/20µs)	1,800 JOULES	1 ns	0-90% NON-CONDENSING	PRIMARY SURGE PROTECTOR WITH INDICATORS, WITH FORM C CONTACTS FOR REMOTE UNIT STATUS MONITORING, 2A@ 30VDC, 0.6A@ 110VDC, 0.6A@ 125VAC	SCREW TERMINALS, ACCEPTS 10AWG AND SMALLER STRANDED WIRE.	SEE FIGURES 6 AND 7	---
-004	120/240 VAC 50/60 HZ 300 A SERVICE	SPLIT PHASE WYE; 3 WIRE + GROUND CONNECTION	---	275 VAC L-L; 150 VAC L-G, L-N, N-G	120,000 A (8/20µs)	1,800 JOULES	1 ns	0-90% NON-CONDENSING	PRIMARY SURGE PROTECTOR WITH INDICATORS, INTERNALLY FUSED, WITH FORM C CONTACTS FOR REMOTE UNIT STATUS MONITORING, 2A@ 30VDC, 0.6A@ 110VDC, 0.6A@ 125VAC	SCREW TERMINALS, ACCEPTS 2 AWG AND SMALLER STRANDED WIRE.	SEE FIGURES 8 AND 9	---
-005	120/240 VAC 50/60 HZ 300 A SERVICE	SPLIT PHASE WYE; 3 WIRE + GROUND CONNECTION	---	275 VAC L-L; 150 VAC L-G, L-N, N-G	120,000 A (8/20µs)	1,800 JOULES	1 ns	0-90% NON-CONDENSING	PRIMARY SURGE PROTECTOR WITH INDICATORS, WITH FORM C CONTACTS FOR REMOTE UNIT STATUS MONITORING, 2A@ 30VDC, 0.6A@ 110VDC, 0.6A@ 125VAC	WIRE LEADS	SEE FIGURES 6 AND 7	THIS SURGE PROTECTOR IS IDENTICAL TO -003 EXCEPT THAT IT HAS FLYING LEADS WIRED TO THE SCREW TERMINALS.

DESCRIPTION: SURGE PROTECTOR WITH INDICATORS

MARKING: MANUFACTURER AND MODEL NUMBER

ELECTRICAL SPECIFICATION:
SEE HPN TABLE.
EACH PHASE IS EQUIPPED WITH A STATUS INDICATOR
HEIGHT.

MATERIAL SPECIFICATION:
SEE HPN TABLE.
STORAGE TEMPERATURE: -40°C TO 70°C
OPERATING TEMPERATURE
-000: -40°C TO 50°C
-001/-005: -40°C TO 70°C

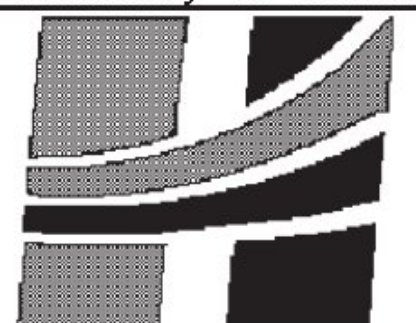
MAXIMUM PHYSICAL DIMENSION:
SEE FIGURES.

- NOTES:**
- TEST CONDITION FOR SURGE ENERGY PER PHASE: 500A AT 5000V FOR 100 CONSECUTIVE TIMES AT A DURATION OF 0.0083 SECONDS EACH PULSE.
 - 010132-001 IS A SPECIAL BN SPECIFIED SURGE PROTECTOR.
 - THE HPN MAY HAVE A -30 SUFFIX TO DENOTE SPECIAL CUSTOMER CONTRACT PRICING. (I.E. 010132-005-30)

TranSystems		Vermont Agency of Transportation Lyndon STPG SGNL(48) Project	
<input type="checkbox"/>	Approved	Fabrication/Installation may be undertaken	
<input checked="" type="checkbox"/>	Approved as Corrected	Approval provided comments are incorporated	
<input type="checkbox"/>	Correct, Revise and Resubmit	Fabrication/Installation MAY NOT be undertaken	
<input type="checkbox"/>	No Action Taken	Review / approval does not relieve the contractor from complying with all the requirements of the contract	

1 - Contractor shall confirm the surge protector is compatible and in-line with the proposed battery system and any additional equipment it may be utilized for.

REVISION CONTROL				
REV	ECRN	DATE	BY	APPRV
A	877-0012	10/27/94	ADH	ADH
B	81284-13	4/7/95	ADH	ADH
CA0	90013308	11/10/97	ADH	ADH
CB0	90024496	12/17/99	DFR	ADH
CC0	90020330	2/6/01	ADH	ADH

ENGINEERING	
Approved A. HOWERY	Date 10/94
Engineer A. HOWERY	
Drawn By A. HOWERY	Date 10/27/94
 Harmon Industries Grain Valley, MO	
Title SURGE PROTECTOR WITH INDICATORS	
Drawing No. 010132-XXX	Sheet 1 of 3