

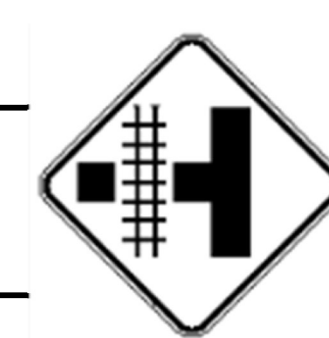


DIRECTION	MILEPOINT	LOCATION CODE (SHEET 4)	SIGN CODE	WIDTH (IN)	HEIGHT (IN)	SHEETING REMARKS	SIGN LEGEND	NEW SIGNS		EXISTING SIGNS			EXIST POST		NUMBER OF NEW POSTS	SQUARE STEEL (IN)			TUBULAR STEEL Ø (IN)				SIGN FRAME REQUIRED	REMARKS	SIGN DETAIL LOCATION				
								"A"	"B"	RETAIN	SALVAGE FROM	SALVAGE TO	REMOVE	RETAIN		REMOVE	1.75	2.00	2.50	FOUNDATION	3.00	3.50			4.00	5.00	SHSM	SIGN DETAILS SHEET #	STANDARD SHEET #
																	(LB / FT)				(LB / FT)								
NB WALLINGFORD VT ROUTE 7B							FY-FLUORESCENT YELLOW FYG-FLUORESCENT YELLOW GREEN															"SHSM"-STANDARD HIGHWAY SIGNS AND MARKINGS BOOK							
NB	0.050	A	M3-1				 7/17/17				1	X																	
		A	VM1-5									1																	
		A	M3-1	24	12																		NORTH, GREEN ON WHITE	X					
		A	VM1-5	24	24																		INSTALL ON RETAINED POST AT SAME STATION		E-136				
NB	0.065	A	R2-1				 7/17/17				1	X																	
		A	R2-1	24	30																		INSTALL ON RETAINED POST AT SAME STATION	X					
NB	0.480	A	W10-3L	36	36		 4/9/18																						
		A	W10-3L																					INSTALL SIGN 210' DOWNSTATION FROM EXISTING SIGN AT MP 0.520 NB	X				
NB	0.520	A	W10-3L				T-INTERSECTION W/ RR CROSSING				1	X																	
SIGN SUMMARY SHEET							SHEET TOTALS	20.00	0.00	0	0	0	4	0	0	2	30.0	0	0.0	0.0	0.0	0.0	PROJECT NAME: STATEWIDE-SOUTH REGION PROJECT NUMBER: STPG SIGN(57)						
VERMONT AGENCY OF TRANSPORTATION							TOWN DIRECTIONAL TOTALS	20.0	0.0	0	0	0	4	0	0	2	30.0	0		0.0		FILE NAME: z16t041Wallinaford7B NB.xls PROJECT MANAGER: D. MUNRO DESIGNED BY: P. MCKECHNIE WALLINGFORD VT-7B NB 1	PLOT DATE: 2/27/2017 DRAWN BY: W. GORDON CHECKED: BRZEZOWSK SHEET 16 OF 264						