
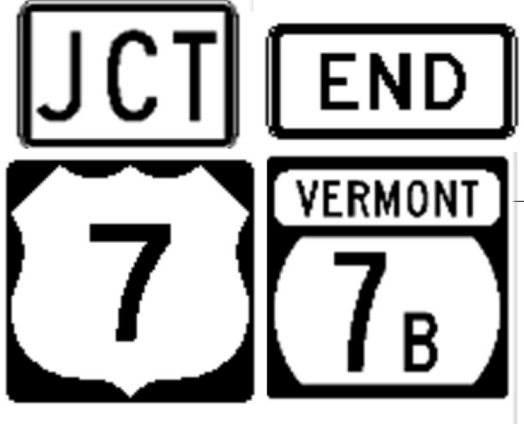


DIRECTION	MILEPOINT	LOCATION CODE (SHEET 4)	SIGN CODE	WIDTH (IN)	HEIGHT (IN)	SHEETING REMARKS	SIGN LEGEND	NEW SIGNS		EXISTING SIGNS			EXIST POST		NUMBER OF NEW POSTS	SQUARE STEEL (IN)			TUBULAR STEEL Ø (IN)				SIGN FRAME REQUIRED	REMARKS	SIGN DETAIL LOCATION				
								"A"	"B"	RETAIN	SALVAGE FROM	SALVAGE TO	REMOVE	RETAIN		REMOVE	1.75	2.00	2.50	FOUNDATION	3.00	3.50			4.00	5.00	SHSM	SIGN DETAILS SHEET #	STANDARD SHEET #
																	(LB / FT)				(LB / FT)								
SB WALLINGFORD VT ROUTE 7B							FY-FLUORESCENT YELLOW FYG-FLUORESCENT YELLOW GREEN															"SHSM"-STANDARD HIGHWAY SIGNS AND MARKINGS BOOK							
SB	0.140	F	W3-1				 7/18/17				1	X											INSTALL ON RETAINED POST THINNING AND TRIMMING	X					
SB	0.090	F	M2-1				 11/27/17				1	X	X																
		F	M1-4									1																	
		F	M4-6									1																	
		F	VM1-5									1																	
		F	M2-1	21	15							2										2A	INSTALL ON RETAINED POSTS JCT, BLACK ON WHITE	X					
		F	M1-4	24	24							4.00												X					
		F	M4-6	24	12							2.00											END, GREEN ON WHITE	X					
		F	VM1-5	24	24						4.00														E-136				
SB	0.050	F	M3-1								1	X	X																
		F	M1-4								1																		
		F	M6-1L								1																		
		F	M3-3								1																		
		F	M1-4								1																		
SIGN SUMMARY SHEET							SHEET TOTALS	18.44	0.00	0	0	0	10	0	0	0	0.0	0	0.0	0.0	0.0	0.0	PROJECT NAME: STATEWIDE-SOUTH REGION PROJECT NUMBER: STPG SIGN(57)						
VERMONT AGENCY OF TRANSPORTATION								SF	SF	EA	EA	EA	EA	EA	EA	EA	FT	EA	LB	LB	LB	LB	FILE NAME: z16t041Wallinaford7B SB.xls PROJECT MANAGER: D. MUNRO DESIGNED BY: P. MCKECHNIE WALLINGFORD VT-7B SB 2	PLOT DATE: 2/27/2017 DRAWN BY: W. GORDON CHECKED: BRZEZOWSK SHEET 18 OF 264					
TOWN DIRECTIONAL TOTALS							63.2	0.0	5	2	2	20	0	0	5	75.0	0		0.0										