






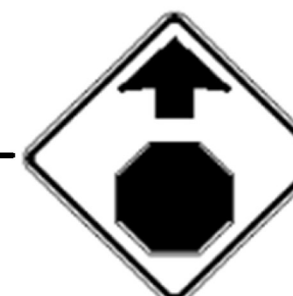



DIRECTION	MILEPOINT	LOCATION CODE (SHEET 4)	SIGN CODE	WIDTH (IN)	HEIGHT (IN)	SHEETING REMARKS	SIGN LEGEND	NEW SIGNS		EXISTING SIGNS			EXIST POST		NUMBER OF NEW POSTS	SQUARE STEEL (IN)			TUBULAR STEEL Ø (IN)				SIGN FRAME REQUIRED	REMARKS	SIGN DETAIL LOCATION				
								"A"	"B"	RETAIN	SALVAGE FROM	SALVAGE TO	REMOVE	RETAIN		REMOVE	1.75	2.00	2.50	FOUNDATION	3.00	3.50			4.00	5.00	SHSM	SIGN DETAILS SHEET #	STANDARD SHEET #
																	(LB / FT)				(LB / FT)								
NB CLARENDON VT ROUTE 7B							FY-FLUORESCENT YELLOW FYG-FLUORESCENT YELLOW GREEN															"SHSM"-STANDARD HIGHWAY SIGNS AND MARKINGS BOOK							
NB	1.946	AB	D3-1				INNOVATION DR					2		X															
		D	R1-1				 7/19/17					1																	
		D	R1-1	30	30																		X						
NB	1.950	AB	D3-1	56	12		 7/19/17																		6				
NB	1.956	A	R2-1				 7/19/17					1		X															
NB	1.975	A	R2-1	24	30		 7/19/17																	X					
NB	2.356	A	W1-2L	30	30		 7/19/17																	X					
NB	2.368	A	VW-205				 7/19/17					1		X															
		A	VW-205	30	30																					T-82			
NB	2.663	A					JCT AHEAD 1000 FT					1		X															
NB	2.786	A	M2-1				 7/19/17					1		X															
		A	VM1-5																										
		A	M2-1	21	15																			X					
		A	VM1-5	30	24		 7/19/17																			E-136			
NB	2.816	A	W3-1	30	30		 7/19/17																	X					
SIGN SUMMARY SHEET							SHEET TOTALS		41.85	0.00	0	0	0	8	0	0	6	90.0	0	0.0	0.0	0.0	0.0	PROJECT NAME: STATEWIDE-SOUTH REGION PROJECT NUMBER: STPG SIGN(57)					
							SF	SF	EA	EA	EA	EA	EA	EA	EA	EA	EA	FT	EA	LB	LB	LB	LB	FILE NAME: z16t041Clarendon7B NB.xls PLOT DATE: 2/27/2017 PROJECT MANAGER: D. MUNRO DRAWN BY: W. GORDON DESIGNED BY: P. MCKECHNIE CHECKED: BRZEZOWSKA CLARENDON VT-7B NB 3 SHEET 22 OF 264					
VERMONT AGENCY OF TRANSPORTATION							TOWN DIRECTIONAL TOTALS		202.9	0.0	5	0	0	40	0	0	27	370.0	2	288.0									