
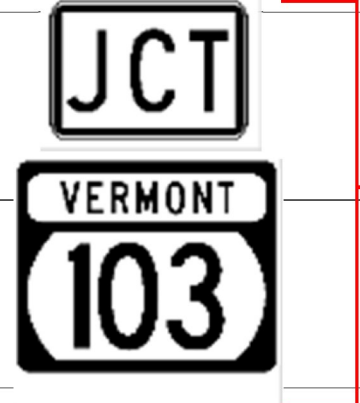



DIRECTION	MILEPOINT	LOCATION CODE (SHEET 4)	SIGN CODE	WIDTH (IN)	HEIGHT (IN)	SHEETING REMARKS	SIGN LEGEND	NEW SIGNS		EXISTING SIGNS				EXIST POST		NUMBER OF NEW POSTS	SQUARE STEEL (IN)			TUBULAR STEEL Ø (IN)				SIGN FRAME REQUIRED	REMARKS	SIGN DETAIL LOCATION			
								"A"	"B"	RETAIN	SALVAGE FROM	SALVAGE TO	REMOVE	RETAIN	REMOVE		1.75	2.00	2.50	FOUNDATION	3.00	3.50	4.00			5.00	SHSM	SIGN DETAILS SHEET #	STANDARD SHEET #
																	(LB / FT)				(LB / FT)								
SB CLARENDON VT ROUTE 7B							FY-FLUORESCENT YELLOW FYG-FLUORESCENT YELLOW GREEN															"SHSM"-STANDARD HIGHWAY SIGNS AND MARKINGS BOOK							
		FE	D3-1	68	12		 7/21/17	5.67							2		10'-3" 9'-9" X									6			
SB	3.045	F	M2-1				 -7/21/17																						
		F	VM1-5																										
		F	M2-1	21	15																								
		F	VM1-5	30	24																						E-136		
SB	3.011	F	W3-1				 7/21/17																						
		F	W3-1	30	30																								
SB	2.966	F	M3-3				SOUTH																						
		F	VM1-5				VERMONT 103																						
		F	M6-1L				LEFT ARROW																						
		F	M4-5				TO																						
		F	M1-4				US ROUTE 7																						
		F	M6-1R				RIGHT ARROW																						
		F	M3-3				SOUTH																						
		F	VM1-5				VERMONT 7B																						
SIGN SUMMARY SHEET							SHEET TOTALS	19.10	0.00	0	0	0	11	0	0	2	30.0	0	0.0	0.0	0.0	0.0	0.0	0.0	PROJECT NAME: STATEWIDE-SOUTH REGION				
								SF	SF	EA	EA	EA	EA	EA	EA	EA	FT	EA	LB	LB	LB	LB	LB	PROJECT NUMBER: STPG SIGN(57)					
VERMONT AGENCY OF TRANSPORTATION							TOWN DIRECTIONAL TOTALS	154.3	0.0	1	0	0	37	0	0	17	220.0	2					279.0	FILE NAME: z16t041Clarendon7B SB.xls PLOT DATE: 2/27/2017					
																								PROJECT MANAGER: D. MUNRO DRAWN BY: W. GORDON					
																								DESIGNED BY: P. MCKECHNIE CHECKED: BRZEZOWSKA					
																								CLARENDON VT-7B SB 2 SHEET 28 OF 264					