
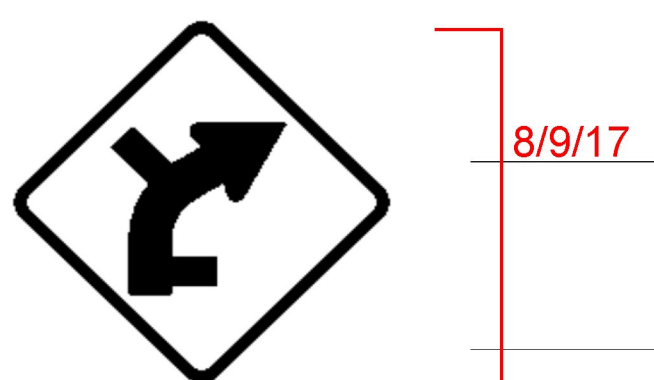



DIRECTION	MILEPOINT	LOCATION CODE (SHEET 4)	SIGN CODE	WIDTH (IN)	HEIGHT (IN)	SHEETING REMARKS	SIGN LEGEND	NEW SIGNS		EXISTING SIGNS			EXIST POST		NUMBER OF NEW POSTS	SQUARE STEEL (IN)			TUBULAR STEEL Ø (IN)				SIGN FRAME REQUIRED	REMARKS	SIGN DETAIL LOCATION				
								"A"	"B"	RETAIN	SALVAGE FROM	SALVAGE TO	REMOVE	RETAIN		REMOVE	1.75	2.00	2.50	FOUNDATION	3.00	3.50			4.00	5.00	SHSM	SIGN DETAILS SHEET #	STANDARD SHEET #
																	(LB / FT)				(LB / FT)								
<b>NB LUDLOW VT ROUTE 103</b>							FY-FLUORESCENT YELLOW FYG-FLUORESCENT YELLOW GREEN															"SHSM"-STANDARD HIGHWAY SIGNS AND MARKINGS BOOK							
NB	0.586	AB	D3-1				Bixby Rd			1	1		X									REMOVE AND SALVAGE TO LEGAL LOAD SIDE OF THE INTERSECTION							
		D	R1-1				STOP					1																	
		C	VD-700				MILE MARKER 1030 / 1410 / 0057			1	1																		
		D	R1-1	30	30		 MILE MARKER 1030 / 1410 / 0057	6.25						1									INSTALL NEW POST 10' FURTHER DOWN TOWN HIGHWAY	X					
		C	VD-700				MILE MARKER 1030 / 1410 / 0057				1											INSTALL BACK TO BACK ON STOP SIGN POST							
NB	0.716	A	R2-1				SPEED LIMIT 40		1				X																
NB	0.767	A	VD-062B				OFFICIAL BUSINESS DIRECTIONAL SIGN		1				X									LaValley's Ludlow Building Supply							
		A	VD-062B				OFFICIAL BUSINESS DIRECTIONAL SIGN		1													The Wine & Cheese Depot left at light							
		A	VD-062B				OFFICIAL BUSINESS DIRECTIONAL SIGN		1													Ludlow Police on west hill road							
NB	0.841	A										1																	
		A	W16-8aP									1																	
		A	W1-2MjR	36	36			9.00						2											2				
		A	W16-8aP	51	15			5.31																	5				
NB	0.881	A	VD-062B				OFFICIAL BUSINESS DIRECTIONAL SIGN		1				X									Business Symbols							
		A	VD-062B				OFFICIAL BUSINESS DIRECTIONAL SIGN		1													Travel Information at Chamber Office (UP) 2							
<b>SIGN SUMMARY SHEET</b>							<b>SHEET TOTALS</b>	20.56	0.00	6	2	1	5	0	0	3	45.0	0	0.0	0.0	0.0	0.0	PROJECT NAME: STATEWIDE-SOUTH REGION PROJECT NUMBER: STPG SIGN(57)						
VERMONT AGENCY OF TRANSPORTATION							<b>TOWN DIRECTIONAL TOTALS</b>	754.3	0.0	42	13	13	190	0	0	65	945.0	0		0.0				FILE NAME: z16t041Ludlow 103 NB.xls PROJECT MANAGER: D. MUNRO DESIGNED BY: P. MCKECHNIE LUDLOW VT-103 NB 3	PLOT DATE: 2/27/2017 DRAWN BY: W. GORDON CHECKED: BRZEZOWSK SHEET 35 OF 264				