
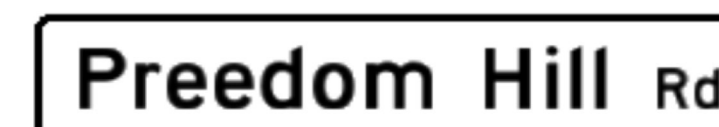





DIRECTION	MILEPOINT	LOCATION CODE (SHEET 4)	SIGN CODE	WIDTH (IN)	HEIGHT (IN)	SHEETING REMARKS	SIGN LEGEND	NEW SIGNS		EXISTING SIGNS			EXIST POST		NUMBER OF NEW POSTS	SQUARE STEEL (IN)			TUBULAR STEEL Ø (IN)				SIGN FRAME REQUIRED	REMARKS	SIGN DETAIL LOCATION				
								"A"	"B"	RETAIN	SALVAGE FROM	SALVAGE TO	REMOVE	RETAIN		REMOVE	1.75	2.00	2.50	FOUNDATION	3.00	3.50			4.00	5.00	SHSM	SIGN DETAILS SHEET #	STANDARD SHEET #
																	(LB / FT)				(LB / FT)								
NB LUDLOW VT ROUTE 103							FY-FLUORESCENT YELLOW FYG-FLUORESCENT YELLOW GREEN															"SHSM"-STANDARD HIGHWAY SIGNS AND MARKINGS BOOK							
		A	M3-1	24	12		 8/10/17	2.00							1	12'-6" X							NORTH, GREEN ON WHITE	X					
		A	VM1-5	30	24			5.00																		E-136			
		A					SCENIC ROUTE 100 BYWAY					1											INSTALL BELOW VT ROUTE 103						
NB	1.034	AB	D3-1				PREEDOM HILL RD					1																	
		AB	D3-1	64	12		 8/10/17	5.33							2	10'-3" 10'-0" X							INSTALL INDEPENDENTLY ON TWO POSTS ON THE LEGAL LOAD SIDE OF THE INTERSECTION		6				
NB	1.036	C	W14-2				NO OUTLET			1		1											PREEDOM HILL RD (TH-19)						
		C	W14-2				NO OUTLET				1				1	12'-0" X							INSTALL 50' FURTHER DOWN TOWN HIGHWAY FROM THE EXISTING LOCATION						
NB	1.036	C	VR-017				 8/10/17					1																	
		C	VR-017	24	30			5.00							1	12'-3" X							INSTALL NEW SIGN IN SAME LOCATION AS NO OUTLET SIGN			T-70			
NB	1.047	D	R1-1				STOP					1																	
		C	VD-700				MILE MARKER 1030 / 1410 / 0104			1		1																	
		D	R1-1	30	30		 8/10/17	6.25							1	12'-9" X								X					
		C	VD-700				MILE MARKER 1030 / 1410 / 0104					1											INSTALL BACK TO BACK ON STOP SIGN POST						
NB	1.051	A	W1-6				ONE DIRECTION LARGE ARROW					1																	
		A	W1-6	48	24		 8/10/17	8.00							2	10'-9" 10'-9" X								X					
SIGN SUMMARY SHEET							SHEET TOTALS	31.58	0.00	0	2	3	6	0	0	8	120.0	0	0.0	0.0	0.0	0.0	PROJECT NAME: STATEWIDE-SOUTH REGION PROJECT NUMBER: STPG SIGN(57)						
VERMONT AGENCY OF TRANSPORTATION							TOWN DIRECTIONAL TOTALS	754.3	0.0	42	13	13	190	0	0	65	945.0	0		0.0			FILE NAME: z16t041Ludlow 103 NB.xls PROJECT MANAGER: D. MUNRO DESIGNED BY: P. MCKECHNIE LUDLOW VT-103 NB 5	PLOT DATE: 2/27/2017 DRAWN BY: W. GORDON CHECKED: BRZEZOWSK SHEET 37 OF 264					