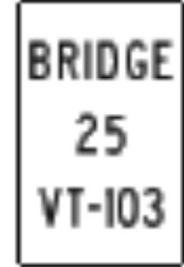



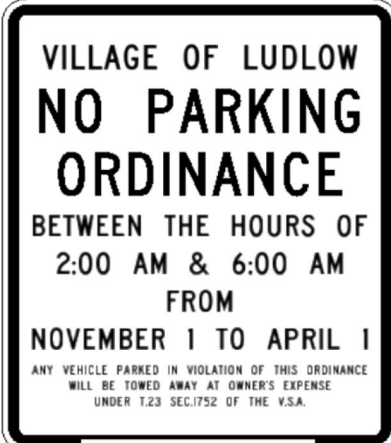



DIRECTION	MILEPOINT	LOCATION CODE (SHEET 4)	SIGN CODE	WIDTH (IN)	HEIGHT (IN)	SHEETING REMARKS	SIGN LEGEND	NEW SIGNS		EXISTING SIGNS			EXIST POST		NUMBER OF NEW POSTS	SQUARE STEEL (IN)			TUBULAR STEEL Ø (IN)				SIGN FRAME REQUIRED	REMARKS	SIGN DETAIL LOCATION				
								"A"	"B"	RETAIN	SALVAGE FROM	SALVAGE TO	REMOVE	RETAIN		REMOVE	1.75	2.00	2.50	FOUNDATION	3.00	3.50			4.00	5.00	SHSM	SIGN DETAILS SHEET #	STANDARD SHEET #
																	(LB / FT)				(LB / FT)								
NB LUDLOW VT ROUTE 103							FY-FLUORESCENT YELLOW FYG-FLUORESCENT YELLOW GREEN															"SHSM"-STANDARD HIGHWAY SIGNS AND MARKINGS BOOK							
NB	1.946	A	VD-701				 8/18/17					1	X									INSTALL ON RETAINED POST			T-42				
		A	VD-701	6	10			0.42																					
NB	1.956	A	W11-2				PEDESTRIAN TRAFFIC					1	X																
		A	W16-7pL				LEFT DIAGONAL ARROW PLAQUE					1																	
		A	W11-2	30	30	FYG	 8/18/17	6.25														INSTALL ON RETAINED POST PROVIDE 7' MINIMUM CLEAR HEIGHT	X						
		A	W16-7pL	24	12	FYG		2.00															X						
NB	2.000	A	R2-1	24	30		 8/29/17	5.00							1	12'-6" X						INSTALL SIGN BEHIND SIDEWALK AND 10' UPSTATION FROM WALKWAY TO TDS TELECOM (111 MAIN ST) PROVIDE 7' MINIMUM CLEAR HEIGHT	X						
NB	2.036	C					 8/29/17					1		X								RETURN SIGN TO TOWN							
		C					TOWN PARKING ORDINANCE SIGN					1										RETURN SIGN TO TOWN							
		C		30	36		 8/29/17	7.50							1	14'-0" X						INSTALL POST IN SAME LOCATION BEHIND CURB PROVIDE 8' MINIMUM CLEAR HEIGHT SIGN INSTALLED AT PROPERTY LINE DUE TO COMPLAINT		3					
		C		12	18			1.50																3					
NB	2.051	A	W11-2				PEDESTRIAN TRAFFIC					1	X																
		A	W16-7pL				LEFT DIAGONAL ARROW PLAQUE					1																	
		A					TOWN PARKING ORDINANCE SIGN					1										RETURN SIGN TO TOWN							
SIGN SUMMARY SHEET							SHEET TOTALS	22.67	0.00	0	0	0	8	0	0	2	30.0	0	0.0	0.0	0.0	0.0	PROJECT NAME: STATEWIDE-SOUTH REGION PROJECT NUMBER: STPG SIGN(57)						
VERMONT AGENCY OF TRANSPORTATION							TOWN DIRECTIONAL TOTALS	754.3	0.0	42	13	13	190	0	0	65	945.0	0		0.0			FILE NAME: z16t041Ludlow 103 NB.xls PROJECT MANAGER: D. MUNRO DESIGNED BY: P. MCKECHNIE LUDLOW VT-103 NB 11	PLOT DATE: 2/27/2017 DRAWN BY: W. GORDON CHECKED: BRZEZOWSK SHEET 43 OF 264					