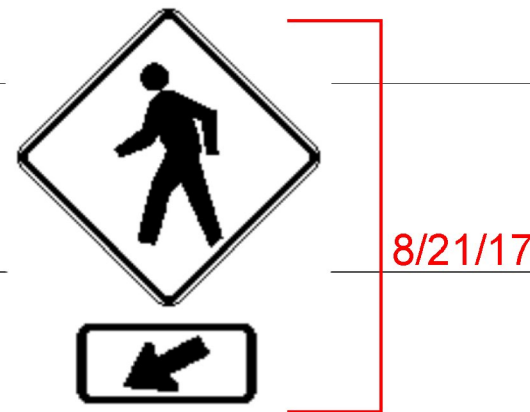


DIRECTION	MILEPOINT	LOCATION CODE (SHEET 4)	SIGN CODE	WIDTH (IN)	HEIGHT (IN)	SHEETING REMARKS	SIGN LEGEND	NEW SIGNS		EXISTING SIGNS				EXIST POST		NUMBER OF NEW POSTS	SQUARE STEEL (IN)			TUBULAR STEEL Ø (IN)				SIGN FRAME REQUIRED	REMARKS	SIGN DETAIL LOCATION			
								"A"	"B"	RETAIN	SALVAGE FROM	SALVAGE TO	REMOVE	RETAIN	REMOVE		1.75	2.00	2.50	FOUNDATION	3.00	3.50	4.00			5.00	SHSM	SIGN DETAILS SHEET #	STANDARD SHEET #
																	(LB / FT)				(LB / FT)								
																	1.88	2.42	3.35		7.60	9.00	10.80			14.60			
NB LUDLOW VT ROUTE 103							FY-FLUORESCENT YELLOW FYG-FLUORESCENT YELLOW GREEN															"SHSM"-STANDARD HIGHWAY SIGNS AND MARKINGS BOOK							
		C	M6-1	21	15			2.19															ARROW, GREEN ON WHITE	X					
		C	M4-5	24	12			2.00															TO, (INTERSTATE) WHITE ON BLUE	X					
		C	M1-1	24	24			4.00																X					
		C	M6-1	21	15			2.19															ARROW, (INTERSTATE) WHITE ON BLUE	X					
NB	2.659	C	R7-1				NO PARKING ANYTIME <---->						1		X								RETURN SIGN TO TOWN						
		C	R7-201				TOW AWAY ZONE PLAQUE						1										RETURN SIGN TO TOWN						
NB	2.679	A	W11-2				PEDESTRIAN TRAFFIC						1	X															
		A	W16-7pL										1																
		A	W11-2	30	30	FYG		6.25																INSTALL ON RETAINED POST PROVIDE 7' MINIMUM CLEAR HEIGHT	X				
		A	W16-7pL	24	12	FYG		2.00																	X				
NB	2.689	AB					TRAVEL INFORMATION			1				X															
NB	2.699	C	R7-1				NO PARKING ANYTIME <---->						1		X								RETURN SIGN TO TOWN						
		C	R7-201				TOW AWAY ZONE PLAQUE						1										RETURN SIGN TO TOWN						
NB	2.714	C					NO PARKING BUS STOP						1		X								RETURN SIGN TO TOWN (NO LONGER A BUS STOP)						
NB	2.719	A	W11-1				BICYCLE WARNING						1	X															
SIGN SUMMARY SHEET						SHEET TOTALS		18.63	0.00	1	0	0	8	0	0	0	0.0			0	0.0	0.0	0.0	0.0	PROJECT NAME: STATEWIDE-SOUTH REGION				
								SF	SF	EA	EA	EA	EA	EA	EA	EA		FT		EA	LB	LB	LB	LB	PROJECT NUMBER: STPG SIGN(57)				
																								FILE NAME: z16t041Ludlow 103 NB.xls		PLOT DATE: 2/27/2017			
						VERMONT AGENCY OF TRANSPORTATION		TOWN DIRECTIONAL TOTALS		754.3	0.0	42	13	13	190	0	0	65	945.0			0	0.0				PROJECT MANAGER: D. MUNRO		DRAWN BY: W. GORDON
																								DESIGNED BY: P. MCKECHNIE		CHECKED: BRZEZOWSKI			
																								LUDLOW VT-103 NB 21		SHEET 53 OF 264			