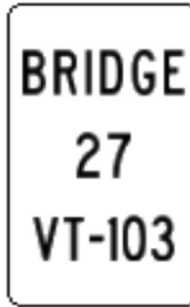


| DIRECTION                        | MILEPOINT | LOCATION CODE (SHEET 4) | SIGN CODE | WIDTH (IN) | HEIGHT (IN) | SHEETING REMARKS                                                                    | SIGN LEGEND                                           | NEW SIGNS    |                             | EXISTING SIGNS |              |            |        | EXIST POST |        | NUMBER OF NEW POSTS | SQUARE STEEL<br>(IN) |       |      | TUBULAR STEEL<br>Ø (IN) |             |                                                    |                           | SIGN FRAME REQUIRED       | REMARKS                             | SIGN DETAIL LOCATION                                                              |                     |                         |                               |  |
|----------------------------------|-----------|-------------------------|-----------|------------|-------------|-------------------------------------------------------------------------------------|-------------------------------------------------------|--------------|-----------------------------|----------------|--------------|------------|--------|------------|--------|---------------------|----------------------|-------|------|-------------------------|-------------|----------------------------------------------------|---------------------------|---------------------------|-------------------------------------|-----------------------------------------------------------------------------------|---------------------|-------------------------|-------------------------------|--|
|                                  |           |                         |           |            |             |                                                                                     |                                                       | "A"          | "B"                         | RETAIN         | SALVAGE FROM | SALVAGE TO | REMOVE | RETAIN     | REMOVE |                     | 1.75                 | 2.00  | 2.50 | FOUNDATION              | 3.00        | 3.50                                               | 4.00                      |                           |                                     | 5.00                                                                              | SHSM                | SIGN DETAILS<br>SHEET # | STANDARD<br>SHEET #           |  |
|                                  |           |                         |           |            |             |                                                                                     |                                                       |              |                             |                |              |            |        |            |        |                     | (LB / FT)            |       |      |                         | (LB / FT)   |                                                    |                           |                           |                                     |                                                                                   |                     |                         |                               |  |
|                                  |           |                         |           |            |             |                                                                                     |                                                       |              |                             |                |              |            |        |            |        |                     | 1.88                 | 2.42  | 3.35 |                         | 7.60        | 9.00                                               | 10.80                     |                           |                                     | 14.60                                                                             |                     |                         |                               |  |
| NB LUDLOW VT ROUTE 103           |           |                         |           |            |             |                                                                                     | FY-FLUORESCENT YELLOW<br>FYG-FLUORESCENT YELLOW GREEN |              |                             |                |              |            |        |            |        |                     |                      |       |      |                         |             | "SHSM"-STANDARD HIGHWAY<br>SIGNS AND MARKINGS BOOK |                           |                           |                                     |                                                                                   |                     |                         |                               |  |
|                                  |           | A                       | W16-1P    |            |             |                                                                                     | SHARE THE ROAD                                        |              |                             |                |              | 1          |        |            |        |                     |                      |       |      |                         |             |                                                    |                           |                           |                                     |                                                                                   |                     |                         |                               |  |
|                                  |           | A                       | W11-1     | 30         | 30          |    | 8/21/17                                               | 6.25         |                             |                |              |            |        |            |        |                     |                      |       |      |                         |             |                                                    |                           | INSTALL ON RETAINED POST  | X                                   |                                                                                   |                     |                         |                               |  |
|                                  |           | A                       | W16-1P    | 18         | 24          |                                                                                     |                                                       | 3.00         |                             |                |              |            |        |            |        |                     |                      |       |      |                         |             |                                                    |                           |                           | INSTALL ON RETAINED POST            | X                                                                                 |                     |                         |                               |  |
| NB                               | 2.733     | C                       | R7-1      |            |             |                                                                                     |                                                       |              | NO PARKING ANYTIME<br>←---→ |                |              |            |        | 1          |        | X                   |                      |       |      |                         |             |                                                    |                           |                           |                                     | RETURN SIGN TO TOWN                                                               |                     |                         |                               |  |
|                                  |           | C                       | R7-201    |            |             |                                                                                     | TOW AWAY ZONE PLAQUE                                  |              |                             |                |              | 1          |        |            |        |                     |                      |       |      |                         |             |                                                    |                           |                           | RETURN SIGN TO TOWN                 |                                                                                   |                     |                         |                               |  |
| NB                               | 2.734     | A                       | VD-701    |            |             |   | 8/21/17                                               |              |                             |                |              | 1          | X      |            |        |                     |                      |       |      |                         |             |                                                    |                           |                           |                                     |                                                                                   |                     |                         |                               |  |
|                                  |           | A                       | VD-701    | 6          | 10          |                                                                                     |                                                       | 0.42         |                             |                |              |            |        |            |        |                     |                      |       |      |                         |             |                                                    |                           |                           | INSTALL ON RETAINED POST            |                                                                                   |                     | T-42                    |                               |  |
| NB                               | 2.739     | A                       |           |            |             |  | 8/21/17                                               |              |                             |                |              | 1          | X      | X          |        |                     |                      |       |      |                         |             |                                                    |                           |                           |                                     |                                                                                   |                     |                         |                               |  |
|                                  |           | A                       | D4-2      | 24         | 30          |                                                                                     |                                                       | 5.00         |                             |                |              |            |        | 1          |        |                     | 13'-3"<br>X          |       |      |                         |             |                                                    |                           |                           |                                     | INSTALL ON RETAINED POST                                                          | X                   |                         |                               |  |
| NB                               | 2.852     | C                       | R7-1      |            |             |                                                                                     | NO PARKING ANYTIME<br>←---→                           |              |                             |                |              | 1          |        | X          |        |                     |                      |       |      |                         |             |                                                    |                           |                           | RETURN SIGN TO TOWN                 |                                                                                   |                     |                         |                               |  |
|                                  |           | C                       | R7-201    |            |             |                                                                                     | TOW AWAY ZONE PLAQUE                                  |              |                             |                |              | 1          |        |            |        |                     |                      |       |      |                         |             |                                                    |                           |                           | RETURN SIGN TO TOWN                 |                                                                                   |                     |                         |                               |  |
| NB                               | 2.853     | A                       | VR-039    |            |             |  | 8/21/17                                               |              |                             |                |              | 1          |        | X          |        |                     |                      |       |      |                         |             |                                                    |                           |                           |                                     | NOTE: END CLASS 1 TOWN HIGHWAY.<br>STICKERS ON BACK OF SIGNS SHALL<br>READ "VAOT" |                     |                         |                               |  |
|                                  |           | A                       | R2-1      |            |             |                                                                                     |                                                       |              |                             |                |              |            |        | 1          |        |                     |                      |       |      |                         |             |                                                    |                           |                           |                                     |                                                                                   |                     |                         |                               |  |
|                                  |           | A                       | VR-039    | 24         | 18          |                                                                                     |                                                       | 3.00         |                             |                |              |            |        |            |        |                     | 1                    |       |      |                         | 14'-9"<br>X |                                                    |                           |                           |                                     |                                                                                   |                     |                         | T-71                          |  |
|                                  |           | A                       | R2-1      | 24         | 30          |                                                                                     |                                                       | 5.00         |                             |                |              |            |        |            |        |                     |                      |       |      |                         |             |                                                    |                           |                           |                                     |                                                                                   |                     | X                       |                               |  |
| SIGN SUMMARY SHEET               |           |                         |           |            |             |                                                                                     |                                                       | SHEET TOTALS |                             | 22.67          | 0.00         | 0          | 0      | 0          | 9      | 0                   | 0                    | 1     |      | 15.0                    |             | 0                                                  | 0.0                       | 0.0                       | 0.0                                 | PROJECT NAME: STATEWIDE-SOUTH REGION                                              |                     |                         | PROJECT NUMBER: STPG SIGN(57) |  |
|                                  |           |                         |           |            |             |                                                                                     |                                                       | SF           | SF                          | EA             | EA           | EA         | EA     | EA         | EA     | EA                  |                      | FT    |      | EA                      | LB          | LB                                                 | LB                        | LB                        | FILE NAME: z16t041Ludlow 103 NB.xls |                                                                                   |                     | PLOT DATE: 2/27/2017    |                               |  |
| VERMONT AGENCY OF TRANSPORTATION |           |                         |           |            |             | TOWN DIRECTIONAL TOTALS                                                             |                                                       | 754.3        | 0.0                         | 42             | 13           | 13         | 190    | 0          | 0      | 65                  |                      | 945.0 |      | 0                       |             | 0.0                                                |                           | PROJECT MANAGER: D. MUNRO |                                     |                                                                                   | DRAWN BY: W. GORDON |                         |                               |  |
|                                  |           DESIGNED BY: P. MCKECHNIE |                           |                                     | CHECKED: BRZEZOWSKI                                                               |                     |                         |                               |  |
|                                  |           LUDLOW VT-103 NB 22       |                           |                                     | SHEET 54 OF 264                                                                   |                     |                         |                               |  |