
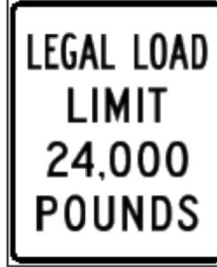


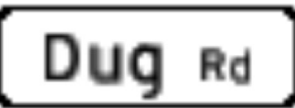

DIRECTION	MILEPOINT	LOCATION CODE (SHEET 4)	SIGN CODE	WIDTH (IN)	HEIGHT (IN)	SHEETING REMARKS	SIGN LEGEND	NEW SIGNS		EXISTING SIGNS			EXIST POST		NUMBER OF NEW POSTS	SQUARE STEEL (IN)			TUBULAR STEEL Ø (IN)				SIGN FRAME REQUIRED	REMARKS	SIGN DETAIL LOCATION				
								"A"	"B"	RETAIN	SALVAGE FROM	SALVAGE TO	REMOVE	RETAIN		REMOVE	1.75	2.00	2.50	FOUNDATION	3.00	3.50			4.00	5.00	SHSM	SIGN DETAILS SHEET #	STANDARD SHEET #
																	(LB / FT)				(LB / FT)								
<b>NB LUDLOW VT ROUTE 103</b>							FY-FLUORESCENT YELLOW FYG-FLUORESCENT YELLOW GREEN															"SHSM"-STANDARD HIGHWAY SIGNS AND MARKINGS BOOK							
NB	3.063	C	VR-017				LLL 24,000 LBS					1	X									DUG RD (TH-3)							
		C	VR-017	24	30		 8/21/17	5.00														INSTALL ON RETAINED POST			T-70				
NB	3.070	D	R1-1				STOP					1	X	X															
		C	VD-700				 MILE MARKER 1030 / 1410 / 0307					1																	
		AB	D3-1	34	12		 8/21/17	2.83						1									INSTALL PERPENDICULAR ON TOP OF STOP SIGN		6				
		D	R1-1	30	30			6.25														<del>INSTALL ON RETAINED POST</del>	X						
NB	3.117	A	R2-1				 8/21/17					1		X															
		A	R2-1	24	30			5.00						1										X					
NB	3.269	A	VD-062B				OFFICIAL BUSINESS DIRECTIONAL SIGN			1				X								Green Mountain at Fox Run							
		A	VD-062A				OFFICIAL BUSINESS DIRECTIONAL SIGN			1												Okemo Valley Golf Club							
		A	VD-062A				OFFICIAL BUSINESS DIRECTIONAL SIGN			1												Willie Dunn's Grille							
NB	3.327	A	VD-062A				OFFICIAL BUSINESS DIRECTIONAL SIGN			1				X								The Okemo Inn							
		A	VD-062A				OFFICIAL BUSINESS DIRECTIONAL SIGN			1												Okemo Valley Nordic Center							
<b>SIGN SUMMARY SHEET</b>							<b>SHEET TOTALS</b>	19.08	0.00	6	0	0	3	0	0	1	15.0	0	0.0	0.0	0.0	0.0	PROJECT NAME: STATEWIDE-SOUTH REGION PROJECT NUMBER: STPG SIGN(57)						
VERMONT AGENCY OF TRANSPORTATION							<b>TOWN DIRECTIONAL TOTALS</b>	754.3	0.0	42	13	13	190	0	0	65	945.0	0		0.0			FILE NAME: z16t041Ludlow 103 NB.xls PROJECT MANAGER: D. MUNRO DESIGNED BY: P. MCKECHNIE LUDLOW VT-103 NB 23	PLOT DATE: 2/27/2017 DRAWN BY: W. GORDON CHECKED: BRZEZOWSK SHEET 55 OF 264					