




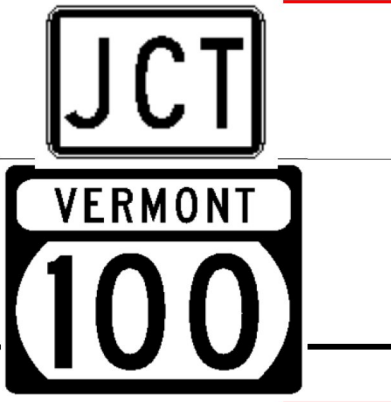

DIRECTION	MILEPOINT	LOCATION CODE (SHEET 4)	SIGN CODE	WIDTH (IN)	HEIGHT (IN)	SHEETING REMARKS	SIGN LEGEND	NEW SIGNS		EXISTING SIGNS			EXIST POST		NUMBER OF NEW POSTS	SQUARE STEEL (IN)			TUBULAR STEEL Ø (IN)				SIGN FRAME REQUIRED	REMARKS	SIGN DETAIL LOCATION				
								"A"	"B"	RETAIN	SALVAGE FROM	SALVAGE TO	REMOVE	RETAIN		REMOVE	1.75	2.00	2.50	FOUNDATION	3.00	3.50			4.00	5.00	SHSM	SIGN DETAILS SHEET #	STANDARD SHEET #
																	(LB / FT)				(LB / FT)								
<b>NB LUDLOW VT ROUTE 103</b>							FY-FLUORESCENT YELLOW FYG-FLUORESCENT YELLOW GREEN															"SHSM"-STANDARD HIGHWAY SIGNS AND MARKINGS BOOK							
			A	VM1-5			VERMONT ROUTE 100					1											INSTALL ON RETAINED POST						
			A	M2-1	21	15	 8/24/17	2.19															JCT, GREEN ON WHITE	X					
			A	VM1-5	30	24		5.00															INSTALL ON RETAINED POST			E-136			
NB	3.907		A	VD1-1A			(UP) E.WALLINGFORD 9					1	X																
			A	VD1-1A			(UP) RUTLAND 23					1																	
			A	VD1-1A			TYSON 4 -->					1																	
			A	VD1-1A			PLYMOUTH 9 -->					1																	
			A	VD1-1A	72	12		6.00															INSTALL ON RETAINED POSTS			T-93			
			A	VD1-1A	72	12		6.00																		T-93			
			A	VD1-1A	72	12		6.00																		T-93			
			A	VD1-1A	72	12		6.00																		T-93			
NB	3.944		A	M3-1			NORTH					1	X																
			A	VM1-5			VERMONT 103					1																	
			A	M6-3			UP ARROW					1																	
			A	M3-1			NORTH					1																	
<b>SIGN SUMMARY SHEET</b>							<b>SHEET TOTALS</b>	31.19	0.00	0	0	0	9	0	0	0	0.0	0	0.0	0.0	0.0	0.0	PROJECT NAME: STATEWIDE-SOUTH REGION						
							SF	SF	EA	EA	EA	EA	EA	EA	EA	EA	EA	EA	EA	EA	EA	EA	PROJECT NUMBER: STPG SIGN(57)						
																								FILE NAME: z16t041Ludlow 103 NB.xls	PLOT DATE: 2/27/2017				
VERMONT AGENCY OF TRANSPORTATION							<b>TOWN DIRECTIONAL TOTALS</b>	754.3	0.0	42	13	13	190	0	0	65	945.0	0		0.0			PROJECT MANAGER: D. MUNRO	DRAWN BY: W. GORDON					
																							DESIGNED BY: P. MCKECHNIE	CHECKED: BRZEZOWSK	SHEET 57	OF 264			
																							LUDLOW VT-103 NB 25						