




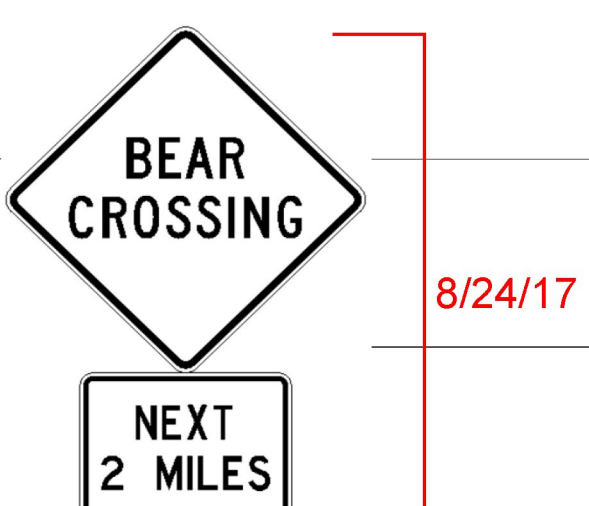

DIRECTION	MILEPOINT	LOCATION CODE (SHEET 4)	SIGN CODE	WIDTH (IN)	HEIGHT (IN)	SHEETING REMARKS	SIGN LEGEND	NEW SIGNS		EXISTING SIGNS			EXIST POST		NUMBER OF NEW POSTS	SQUARE STEEL (IN)			TUBULAR STEEL Ø (IN)				SIGN FRAME REQUIRED	REMARKS	SIGN DETAIL LOCATION				
								"A"	"B"	RETAIN	SALVAGE FROM	SALVAGE TO	REMOVE	RETAIN		REMOVE	1.75	2.00	2.50	FOUNDATION	3.00	3.50			4.00	5.00	SHSM	SIGN DETAILS SHEET #	STANDARD SHEET #
																	(LB / FT)				(LB / FT)								
NB LUDLOW VT ROUTE 103							FY-FLUORESCENT YELLOW FYG-FLUORESCENT YELLOW GREEN															"SHSM"-STANDARD HIGHWAY SIGNS AND MARKINGS BOOK							
NB	4.520	A	VW-050				BEAR CROSSING					1	X																
		A	W7-3aP				NEXT 2 MILES					1																	
		A	VW-050	30	30							6.25										INSTALL ON RETAINED POST		2					
		A	W7-3aP	24	18							3.00											X						
NB	4.545	A	R4-6				TRUCK LANE 500 FEET					1	X																
		A	VD-700				MILE MARKER 1030 / 1410 / 0460			1		1										SALVAGE TO NEW POST AT MP 4.600 NB							
NB	4.600	A	VD-700				10/25/17 MILE MARKER 1030 / 1410 / 0460					1		1															
		A	R4-3									1	X																
		A	R4-3	24	30							5.00										INSTALL ON RETAINED POST	X						
NB	5.041	A	R4-3									1	X																
		A	R4-3	24	30							5.00										INSTALL ON RETAINED POST	X						
NB	5.235	A	R4-3									1	X																
		A	R4-3	24	30							5.00											X						
NB	5.458	A	W9-1R									1	X																
		A	W9-1R	36	36							9.00										INSTALL ON RETAINED POSTS	X						
SIGN SUMMARY SHEET							SHEET TOTALS	33.25	0.00	0	1	1	8	0	0	2	25.0	0	0.0	0.0	0.0	0.0	PROJECT NAME: STATEWIDE-SOUTH REGION PROJECT NUMBER: STPG SIGN(57)						
VERMONT AGENCY OF TRANSPORTATION							TOWN DIRECTIONAL TOTALS	754.3	0.0	42	13	13	190	0	0	65	945.0	0		0.0				FILE NAME: z16t041Ludlow 103 NB.xls PROJECT MANAGER: D. MUNRO DESIGNED BY: P. MCKECHNIE LUDLOW VT-103 NB 28	PLOT DATE: 2/27/2017 DRAWN BY: W. GORDON CHECKED: BRZEZOWSK SHEET 60 OF 264				