
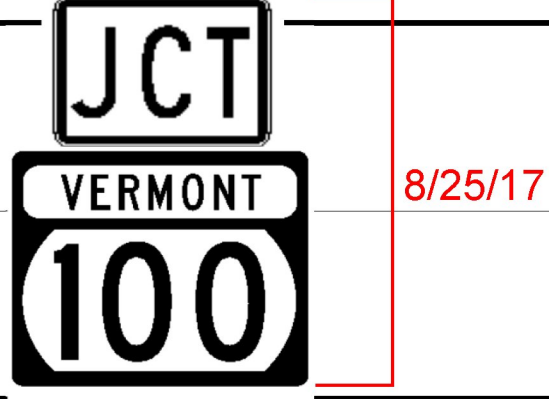


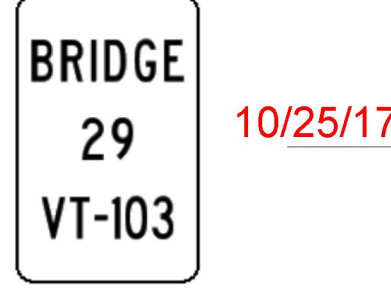


DIRECTION	MILEPOINT	LOCATION CODE (SHEET 4)	SIGN CODE	WIDTH (IN)	HEIGHT (IN)	SHEETING REMARKS	SIGN LEGEND	NEW SIGNS		EXISTING SIGNS			EXIST POST		NUMBER OF NEW POSTS	SQUARE STEEL (IN)			TUBULAR STEEL Ø (IN)				SIGN FRAME REQUIRED	REMARKS	SIGN DETAIL LOCATION				
								"A"	"B"	RETAIN	SALVAGE FROM	SALVAGE TO	REMOVE	RETAIN		REMOVE	1.75	2.00	2.50	FOUNDATION	3.00	3.50			4.00	5.00	SHSM	SIGN DETAILS SHEET #	STANDARD SHEET #
																	(LB / FT)				(LB / FT)								
<b>SB LUDLOW VT ROUTE 103</b>							FY-FLUORESCENT YELLOW FYG-FLUORESCENT YELLOW GREEN															"SHSM"-STANDARD HIGHWAY SIGNS AND MARKINGS BOOK							
SB	4.323	G	R1-1				STOP			1																			
SB	4.292	F	M2-1	21	15			2.19						1									JCT, GREEN ON WHITE INSTALL 240 FT ± NORTH OF EXISTING SIGN AT MP 4.251 SB	X					
		F	VM1-5	30	24			5.00																	E-136				
SB	4.280	F	VD-701								1															T-42			
		F	VD-701	6	10			0.42						1															
<b>MILE POINT 4.015 - 4.267 BEGIN BREAK IN SIGN PROJECT. RESUME PROJECT JUST BEYOND LOCUST ROAD</b>																													
SB	3.980	F	VD2-1				OKEMO MTN SKI AREA 2				1																		
		F	VD2-1				LUDLOW 2				1																		
		F	VD2-1Sa	72	12			6.00						2											3				
		F	VD2-1	72	12			6.00																			T-93		
SB	3.936	F	R2-1								1																		
		F	R2-1	24	30			5.00																					
SB	3.901	F	VD-062B				OFFICIAL BUSINESS DIRECTIONAL SIGN			1																			
		F	VD-062B				OFFICIAL BUSINESS DIRECTIONAL SIGN			1																			
SB	3.834	F	VD-062B				OFFICIAL BUSINESS DIRECTIONAL SIGN			1																			
<b>SIGN SUMMARY SHEET</b>							<b>SHEET TOTALS</b>	24.60	0.00	4	0	0	4	0	0	4	55.0	0	0.0	0.0	0.0	0.0	PROJECT NAME: STATEWIDE-SOUTH REGION PROJECT NUMBER: STPG SIGN(57)						
VERMONT AGENCY OF TRANSPORTATION							<b>TOWN DIRECTIONAL TOTALS</b>	502.1	0.0	48	5	5	120	0	0	62	870.0	2	217.0				FILE NAME: z16t041Ludlow 103 SB.xls PROJECT MANAGER: D. MUNRO DESIGNED BY: P. MCKECHNIE LUDLOW VT-103 SB 2						
																					PLOT DATE: 2/27/2017 DRAWN BY: W. GORDON CHECKED: BRZEZOWSK SHEET 63 OF 264								