
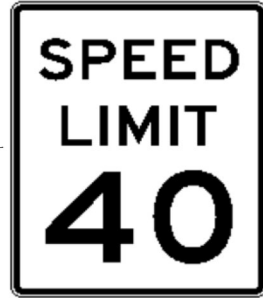





DIRECTION	MILEPOINT	LOCATION CODE (SHEET 4)	SIGN CODE	WIDTH (IN)	HEIGHT (IN)	SHEETING REMARKS	SIGN LEGEND	NEW SIGNS		EXISTING SIGNS				EXIST POST		NUMBER OF NEW POSTS	SQUARE STEEL (IN)			TUBULAR STEEL Ø (IN)				SIGN FRAME REQUIRED	REMARKS	SIGN DETAIL LOCATION			
								"A"	"B"	RETAIN	SALVAGE FROM	SALVAGE TO	REMOVE	RETAIN	REMOVE		1.75	2.00	2.50	FOUNDATION	3.00	3.50	4.00			5.00	SHSM	SIGN DETAILS SHEET #	STANDARD SHEET #
																	(LB / FT)				(LB / FT)								
<b>SB LUDLOW VT ROUTE 103</b>							FY-FLUORESCENT YELLOW FYG-FLUORESCENT YELLOW GREEN															"SHSM"-STANDARD HIGHWAY SIGNS AND MARKINGS BOOK							
		F	VD-062B				OFFICIAL BUSINESS DIRECTIONAL SIGN		1														Tina's Fun Stuff to Wear right at light						
SB	3.225	F	VD-062B				OFFICIAL BUSINESS DIRECTIONAL SIGN		1				X										Business Symbols						
		F	VD-062B				OFFICIAL BUSINESS DIRECTIONAL SIGN		1														Travel Information ahead on left						
SB	3.196	F	W3-5				 8/22/17						1	X									INSTALL SIGN ON RETAINED POSTS	X					
		F	W3-5	36	36			9.00																					
SB	3.121	F	R2-1				 8/22/17						1	X									INSTALL SIGN ON RETAINED POST	X					
		F	R2-1	30	36			7.50																					
SB	3.031	F	VD-062B				OFFICIAL BUSINESS DIRECTIONAL SIGN		1				X										Academy Museum left at lt. then 2nd rt.						
		F	VD-062B				OFFICIAL BUSINESS DIRECTIONAL SIGN		1														Catholic Church left at light						
		F	VD-062B				OFFICIAL BUSINESS DIRECTIONAL SIGN		1														Ludlow Police on west hill road						
SB	2.995	F	W3-5				 8/22/17						1	X									INSTALL SIGN ON RETAINED POSTS	X					
		F	W3-5	36	36			9.00																					
SB	2.948	F	VD-018A	36	24		 8/22/17								1								INSTALL SIGN 250' SOUTH OF EXISTING SIGN AT MP 2.995 SB.			T-95			
		F	VD-018A	36	24			6.00																					
SB	2.916	F	W11-2	30	30		 8/24/17								1								INSTALL SIGN 315' UPSTATION FROM EXISTING SIGN AT MP 2.856 SB	X					
		F	W16-1P	18	24			6.25																					
		F	W16-1P	18	24			3.00																	X				
<b>SIGN SUMMARY SHEET</b>							<b>SHEET TOTALS</b>	40.75	0.00	6	0	0	3	0	0	2	30.0	0	0.0	0.0	0.0	0.0	PROJECT NAME: STATEWIDE-SOUTH REGION						
							SF	SF	EA	EA	EA	EA	EA	EA	EA	EA	FT	EA	LB	LB	LB	LB	PROJECT NUMBER: STPG SIGN(57)						
VERMONT AGENCY OF TRANSPORTATION							<b>TOWN DIRECTIONAL TOTALS</b>	502.1	0.0	48	5	5	120	0	0	62	870.0	2			217.0	FILE NAME: z16t041Ludlow 103 SB.xls	PLOT DATE: 2/27/2017						
																					PROJECT MANAGER: D. MUNRO	DRAWN BY: W. GORDON							
																					DESIGNED BY: P. MCKECHNIE	CHECKED: BRZEWOSKI							
																					LUDLOW VT-103 SB 4	SHEET 65	OF	264					