

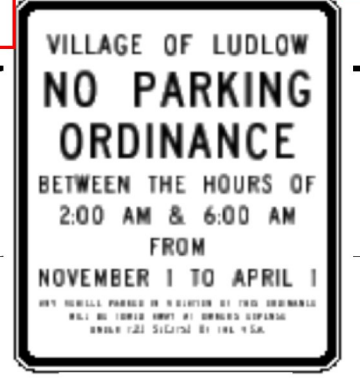





DIRECTION	MILEPOINT	LOCATION CODE (SHEET 4)	SIGN CODE	WIDTH (IN)	HEIGHT (IN)	SHEETING REMARKS	SIGN LEGEND	NEW SIGNS		EXISTING SIGNS			EXIST POST		NUMBER OF NEW POSTS	SQUARE STEEL (IN)			TUBULAR STEEL Ø (IN)				SIGN FRAME REQUIRED	REMARKS	SIGN DETAIL LOCATION				
								"A"	"B"	RETAIN	SALVAGE FROM	SALVAGE TO	REMOVE	RETAIN		REMOVE	1.75	2.00	2.50	FOUNDATION	3.00	3.50			4.00	5.00	SHSM	SIGN DETAILS SHEET #	STANDARD SHEET #
																	(LB / FT)				(LB / FT)								
<b>SB LUDLOW VT ROUTE 103</b>							FY-FLUORESCENT YELLOW FYG-FLUORESCENT YELLOW GREEN															"SHSM"-STANDARD HIGHWAY SIGNS AND MARKINGS BOOK							
SB	2.050	F	W11-2				PEDESTRIAN TRAFFIC					1	X																
		F	W16-7pL				LEFT DIAGONAL ARROW PLAQUE					1																	
		F	R7-8				RESERVED PARKING (HANDICAP SYMBOL) <--->					1										RETURN SIGN TO TOWN							
		F	W11-2	30	30	FYG		8/21/17	6.25													INSTALL ON RETAINED POST. PROVIDE 7' MINIMUM CLEAR HEIGHT	X						
		F	W16-7pL	24	12	FYG			2.00														X						
SB	2.022	G		30	36			8/22/17	7.50				1								14'-9" X			3					
		G		12	18				1.50															3					
SB	1.964	F	W11-2				PEDESTRIAN TRAFFIC					1	X																
		F	W16-7pL				LEFT DIAGONAL ARROW PLAQUE					1																	
		F	W11-2	30	30	FYG		8/18/17	6.25													INSTALL ON RETAINED POST. PROVIDE 7' MINIMUM CLEAR HEIGHT	X						
		F	W16-7pL	24	12	FYG			2.00														X						
SB	1.954	FE	D3-1				Elm St			1			X																
		H	R1-1				STOP			1																			
<b>SIGN SUMMARY SHEET</b>							SHEET TOTALS	25.50	0.00	2	0	0	5	0	0	1	15.0	0	0.0	0.0	0.0	0.0		PROJECT NAME: STATEWIDE-SOUTH REGION					
								SF	SF	EA	EA	EA	EA	EA	EA	EA	FT	EA	LB	LB	LB	LB	FILE NAME: z16t041Ludlow 103 SB.xls		PLOT DATE: 2/27/2017				
VERMONT AGENCY OF TRANSPORTATION							TOWN DIRECTIONAL TOTALS	502.1	0.0	48	5	5	120	0	0	62	870.0	2			217.0		PROJECT MANAGER: D. MUNRO		DRAWN BY: W. GORDON				
																						DESIGNED BY: P. MCKECHNIE		CHECKED: BRZEZOWSKA					
																						LUDLOW VT-103 SB 15		SHEET 76	OF 264				