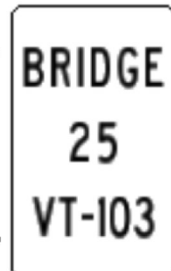


DIRECTION	MILEPOINT	LOCATION CODE (SHEET 4)	SIGN CODE	WIDTH (IN)	HEIGHT (IN)	SHEETING REMARKS	SIGN LEGEND	NEW SIGNS		EXISTING SIGNS				EXIST POST		NUMBER OF NEW POSTS	SQUARE STEEL (IN)			TUBULAR STEEL Ø (IN)				SIGN FRAME REQUIRED	REMARKS	SIGN DETAIL LOCATION			
								"A"	"B"	RETAIN	SALVAGE FROM	SALVAGE TO	REMOVE	RETAIN	REMOVE		1.75	2.00	2.50	FOUNDATION	3.00	3.50	4.00			5.00	SHSM	SIGN DETAILS SHEET #	STANDARD SHEET #
																	(LB / FT)				(LB / FT)								
																	1.88	2.42	3.35		7.60	9.00	10.80			14.60			
SB LUDLOW VT ROUTE 103							FY-FLUORESCENT YELLOW FYG-FLUORESCENT YELLOW GREEN															"SHSM"-STANDARD HIGHWAY SIGNS AND MARKINGS BOOK							
SB	1.949	F	VD-701				 8/28/17	0.42							1	6'-9" X												T-42	
		F	VD-701	6	10																								
SB	1.890	F	W11-2				 8/30/17																						
		F	W16-7pL																										
SB	1.875	F	W11-2	30	30	FYG		6.25							1	14'-3" X								INSTALL POST IN GRASS BEHIND SIDEWALK 5' UPSTATION OF BRICK WALKWAY AT CROSSWALK INSTALLED AT EXISTING LOCATION	X				
		F	W16-7pL	24	12	FYG		2.00																PROVIDE 7' MINIMUM CLEAR HEIGHT	X				
SB	1.865	G																						RETURN SIGN TO TOWN					
SB	1.856	FE	D3-1																					MEADOW ST (TH-326)					
		H	R1-1																										
		F	VD-700																										
		FE	D3-1	42	12		 8/21/17	3.50							1	13'-3" X								INSTALL ON TOP OF STOP SIGN		7			
		H	R1-1	30	30				6.25															INSTALL ON RETAINED POST	X				
SB	1.855	G																						RETURN SIGN TO TOWN					
SB	1.840	G	R7-108																										
SIGN SUMMARY SHEET							SHEET TOTALS	18.42	0.00	2	0	0	7	0	0	2	25.0			0	0.0	0.0	0.0	0.0	PROJECT NAME: STATEWIDE-SOUTH REGION				
								SF	SF	EA	EA	EA	EA	EA	EA	EA		FT		EA	LB	LB	LB	LB	PROJECT NUMBER: STPG SIGN(57)				
																									FILE NAME: z16t041Ludlow 103 SB.xls				
							VERMONT AGENCY OF TRANSPORTATION																			PLOT DATE: 2/27/2017			
							TOWN DIRECTIONAL TOTALS	502.1	0.0	48	5	5	120	0	0	62	870.0			2	217.0				PROJECT MANAGER: D. MUNRO				
																								DRAWN BY: W. GORDON					
																								CHECKED: BRZEZOWSKI					
																								SHEET 77 OF 264					