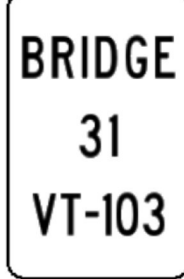
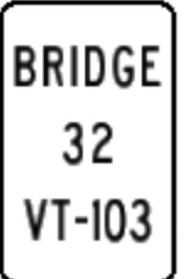
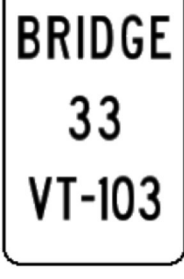



DIRECTION	MILEPOINT	LOCATION CODE (SHEET 4)	SIGN CODE	WIDTH (IN)	HEIGHT (IN)	SHEETING REMARKS	SIGN LEGEND	NEW SIGNS		EXISTING SIGNS			EXIST POST		NUMBER OF NEW POSTS	SQUARE STEEL (IN)			TUBULAR STEEL Ø (IN)				SIGN FRAME REQUIRED	REMARKS	SIGN DETAIL LOCATION								
								"A"	"B"	RETAIN	SALVAGE FROM	SALVAGE TO	REMOVE	RETAIN		REMOVE	1.75	2.00	2.50	FOUNDATION	3.00	3.50			4.00	5.00	SHSM	SIGN DETAILS SHEET #	STANDARD SHEET #				
																	(LB / FT)				(LB / FT)												
NB MOUNT HOLLY VT ROUTE 103							FY-FLUORESCENT YELLOW FYG-FLUORESCENT YELLOW GREEN															"SHSM"-STANDARD HIGHWAY SIGNS AND MARKINGS BOOK											
NB	0.000	A	VD-024				Mount Holly Ludlow			1				X																			
		A	VD-025				Rutland Co. Windsor Co.			1																							
		A	VD-700				MILE MARKER 1030 / 1410 / 0578			1																							
		A	VD-700				MILE MARKER 1030 / 1112 / 0000			1																							
NB	0.057	A	VD-701				 BRIDGE 31 VT-103 9/5/17						1		X																		
		A	VD-701	6	10			0.42					1																			T-42	
NB	0.794	A	VD-701				BRIDGE / 32 / VT 103						1		X																		
		A	VD-700				MILE MARKER 1030 / 1112 / 0080			1		1																					
		A	VD-701	6	10		 BRIDGE 32 VT-103 9/5/17	0.42					1																				T-42
		A	VD-700				MILE MARKER 1030 / 1112 / 0080					1																					
NB	1.032	A	VD-701	6	10		 BRIDGE 33 VT-103 9/5/17	0.42					1																				T-42
NB	1.033	A	OM3-R				RIGHT OBJECT MARKER						1		X																		
		A	VD-701				BRIDGE / 33 / VT 103						1																				
		A	OM3-R	12	36		 9/5/17	3.00					1																				X
SIGN SUMMARY SHEET							SHEET TOTALS	4.25	0.00	4	1	1	5	0	0	4	45.0	0	0.0	0.0	0.0	0.0	PROJECT NAME: STATEWIDE-SOUTH REGION PROJECT NUMBER: STPG SIGN(57)										
VERMONT AGENCY OF TRANSPORTATION							TOWN DIRECTIONAL TOTALS	349.8	0.0	22	7	7	78	0	0	48	680.0	0		0.0	FILE NAME: z16t041Mt Holliv103 NB.xls PROJECT MANAGER: D. MUNRO DESIGNED BY: P. MCKECHNIE MOUNT HOLLY VT-103 NB 1	PLOT DATE: 2/27/2017 DRAWN BY: W. GORDON CHECKED: BRZEZOWSKA SHEET 83 OF 264											