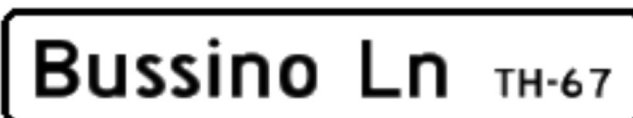
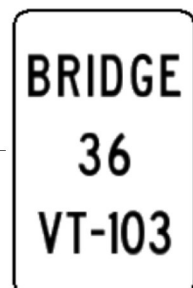


DIRECTION	MILEPOINT	LOCATION CODE (SHEET 4)	SIGN CODE	WIDTH (IN)	HEIGHT (IN)	SHEETING REMARKS	SIGN LEGEND	NEW SIGNS		EXISTING SIGNS				EXIST POST		NUMBER OF NEW POSTS	SQUARE STEEL (IN)			TUBULAR STEEL Ø (IN)				SIGN FRAME REQUIRED	REMARKS	SIGN DETAIL LOCATION					
								"A"	"B"	RETAIN	SALVAGE FROM	SALVAGE TO	REMOVE	RETAIN	REMOVE		1.75	2.00	2.50	FOUNDATION	3.00	3.50	4.00			5.00	SHSM	SIGN DETAILS SHEET #	STANDARD SHEET #		
																	(LB / FT)				(LB / FT)										
																	1.88	2.42	3.35		7.60	9.00	10.80			14.60					
NB MOUNT HOLLY VT ROUTE 103							FY-FLUORESCENT YELLOW FYG-FLUORESCENT YELLOW GREEN															"SHSM"-STANDARD HIGHWAY SIGNS AND MARKINGS BOOK									
NB	2.892	AB	D3-1				MARKWELL LN TH58						1		X																
NB	3.429	C	VR-017				 8/16/17						1		X									BUSSINO LN (TH-67)							
		C	VR-017	24	30			5.00								1	12'-3" X							INSTALL NEW SIGN AT SAME LOCATION ON BUSSINO LN			T-70				
NB	3.432	AB	D3-1	60	12		 8/16/17	5.00								2	12'-0" 12'-3" X							INSTALL INDEPENDENTLY ON TWO POSTS ON LEGAL LOAD SIDE OF THE INTERSECTION		7					
NB	3.440	D	R1-1				STOP					1	X																		
		C	VD-700				MILE MARKER 1030 / 1112 / 0345			1																					
		D	R1-1	30	30		 8/16/17	6.25																INSTALL ON RETAINED POST	X						
NB	3.564	A	VD-701				 8/22/17					1		X																	
		A	VD-701	6	10			0.42								1	8'-0" X									T-42					
NB	3.924	A					 8/23/17					1	X																		
		A		24	24			4.00																INSTALL ON RETAINED POST		3					
NB	4.034	A					EMPTY POST							X										REMOVE POST. PAID FOR AS ITEM 675.12, REMOVING DELINEATORS.							
NB	4.039	A					PARKING AREA <---					1	X																		
		A		24	18		 8/23/17	3.00																INSTALL ON RETAINED POST		3					
		A	M6-1	21	15		 8/23/17	2.19																LEFT ARROW, WHITE ON BLUE	X						
SIGN SUMMARY SHEET							SHEET TOTALS			25.85	0.00	1	0	0	6	0	0	4	55.0			0	0.0	0.0	0.0	0.0	PROJECT NAME: STATEWIDE-SOUTH REGION				
										SF	SF	EA	EA	EA	EA	EA	EA	EA	FT				EA	LB	LB	LB	LB	PROJECT NUMBER: STPG SIGN(57)			
																									FILE NAME: z16t041Mt Hollv103 NB.xls			PLOT DATE: 2/27/2017			
							VERMONT AGENCY OF TRANSPORTATION																					PROJECT MANAGER: D. MUNRO			DRAWN BY: W. GORDON
							TOWN DIRECTIONAL TOTALS			349.8	0.0	22	7	7	78	0	0	48	680.0			0	0.0			DESIGNED BY: P. MCKECHNIE			CHECKED: BRZEZOWSKI		
																										MOUNT HOLLY VT-103 NB 5			SHEET 87 OF 264		