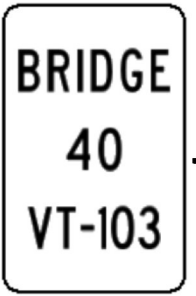
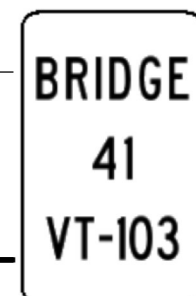

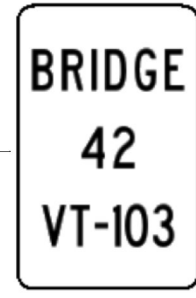






DIRECTION	MILEPOINT	LOCATION CODE (SHEET 4)	SIGN CODE	WIDTH (IN)	HEIGHT (IN)	SHEETING REMARKS	SIGN LEGEND	NEW SIGNS		EXISTING SIGNS			EXIST POST		NUMBER OF NEW POSTS	SQUARE STEEL (IN)			TUBULAR STEEL Ø (IN)				SIGN FRAME REQUIRED	REMARKS	SIGN DETAIL LOCATION				
								"A"	"B"	RETAIN	SALVAGE FROM	SALVAGE TO	REMOVE	RETAIN		REMOVE	1.75	2.00	2.50	FOUNDATION	3.00	3.50			4.00	5.00	SHSM	SIGN DETAILS SHEET #	STANDARD SHEET #
																	(LB / FT)				(LB / FT)								
NB MOUNT HOLLY VT ROUTE 103							FY-FLUORESCENT YELLOW FYG-FLUORESCENT YELLOW GREEN															"SHSM"-STANDARD HIGHWAY SIGNS AND MARKINGS BOOK							
		A	VD-701	6	10		 8/23/17	0.42														INSTALL ON RETAINED POST			T-42				
NB	5.902	A	W5-2				NARROW BRIDGE					1																	
		A	VD-701				BRIDGE / 41 / VT103					1																	
		A	VD-701	6	10		 8/23/17	0.42					1		8'-3" X									T-42					
NB	5.919	A	VW-619	30	30		 9/8/17	6.25							13'-6" X						INSTALL ±90 FT UPSTATION OF EXISTING SIGN AT MP 5.902 NB			T-82					
NB	6.019	A	VD-701				 9/7/17					1																	
		A	VD-701	6	10		 9/7/17	0.42							7'-0" X									T-42					
NB	6.020	A	OM3-R	12	36		 9/7/17	3.00							10'-9" X							X							
NB	6.029	A	OM3-L	12	36		 9/7/17	3.00							10'-9" X							X							
NB	6.184	A	W7-1				HILL					1																	
		A	VD-700				MILE MARKER 1030 / 1112 / 0620			1	1																		
		A	W7-1a	30	30		 8/23/17	6.25							14'-0" X							X							
NB	6.200	A	VD-700				8/23/17 MILE MARKER 1030 / 1112 / 0620				1				8'-6" X						INSTALL ±85 FT UPSTATION OF EXISTING SIGN AT MP 6.184 NB								
NB	6.254	A	VW-060				HIDDEN DRIVES					1																	
		A	S3-1				SCHOOL BUS STOP AHEAD					1																	
SIGN SUMMARY SHEET							SHEET TOTALS	19.75	0.00	0	1	1	7	0	0	7	90.0	0	0.0	0.0	0.0	0.0	PROJECT NAME: STATEWIDE-SOUTH REGION PROJECT NUMBER: STPG SIGN(57)						
VERMONT AGENCY OF TRANSPORTATION							TOWN DIRECTIONAL TOTALS	349.8	0.0	22	7	7	78	0	0	48	680.0	0		0.0			FILE NAME: z16t041Mt Holliv103 NB.xls PROJECT MANAGER: D. MUNRO DESIGNED BY: P. MCKECHNIE MOUNT HOLLY VT-103 NB 9	PLOT DATE: 2/27/2017 DRAWN BY: W. GORDON CHECKED: BRZEZOWSK SHEET 91 OF 264					