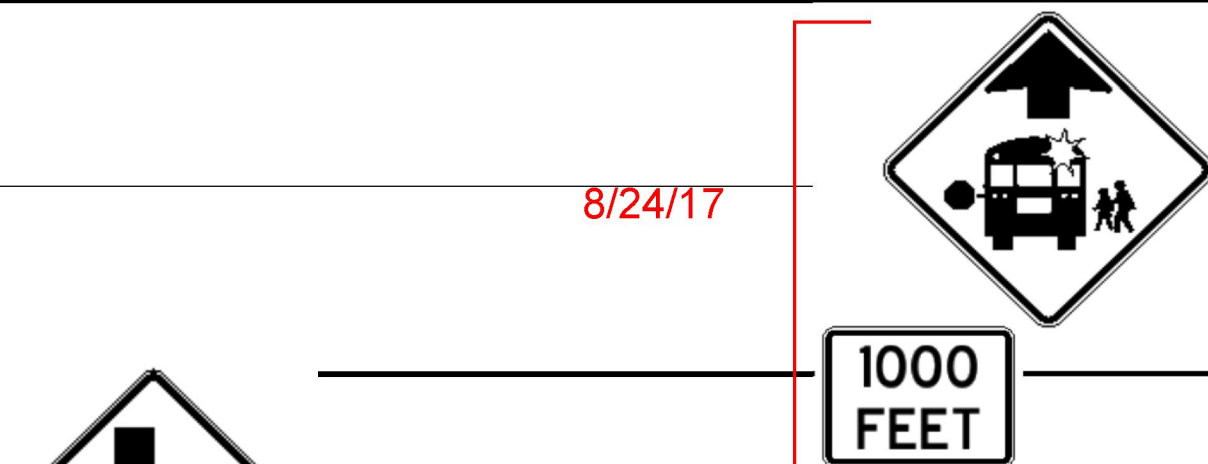
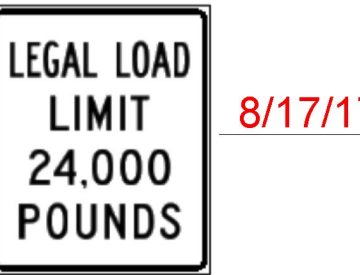
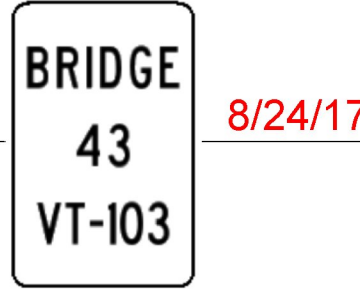


DIRECTION	MILEPOINT	LOCATION CODE (SHEET 4)	SIGN CODE	WIDTH (IN)	HEIGHT (IN)	SHEETING REMARKS	SIGN LEGEND	NEW SIGNS		EXISTING SIGNS				EXIST POST		NUMBER OF NEW POSTS	SQUARE STEEL (IN)			TUBULAR STEEL Ø (IN)				SIGN FRAME REQUIRED	REMARKS	SIGN DETAIL LOCATION			
								"A"	"B"	RETAIN	SALVAGE FROM	SALVAGE TO	REMOVE	RETAIN	REMOVE		1.75	2.00	2.50	FOUNDATION	3.00	3.50	4.00			5.00	SHSM	SIGN DETAILS SHEET #	STANDARD SHEET #
																	(LB / FT)				(LB / FT)								
																	1.88	2.42	3.35		7.60	9.00	10.80			14.60			
NB MOUNT HOLLY VT ROUTE 103							FY-FLUORESCENT YELLOW FYG-FLUORESCENT YELLOW GREEN															"SHSM"-STANDARD HIGHWAY SIGNS AND MARKINGS BOOK							
		A	S3-1	36	36	FYG		9.00								2	15'-6" 15'-0" X							X					
		A	W16-2P	24	18	FYG		3.00																INSTALL ON LEFT POST	X				
NB	6.315	A	W2-2	30	30			6.25								1	13'-0" X								X				
		A	W16-8P	24	8			1.33																		5			
NB	6.372	A	VW-133R	30	30			6.25								1	14'-0" X											T-81	
NB	6.424	C	VR-017									1	X																
		C	VR-017	24	30			5.00																			T-70		
NB	6.432	AB	D3-1				TH18 PACKER RD			1				X															
NB	6.432	D	R1-1				STOP					1		X															
		C	VD-700				MILE MARKER 1030 / 1112 / 0645				1		1																
		D	R1-1	30	30			6.25								1	12'-9" X								X				
		C	VD-700				MILE MARKER 1030 / 1112 / 0645					1																	
NB	7.100	A	VD-701										1	X															
		A	VD-701	6	10			0.42																			T-42		
NB	7.314	A	R2-1	24	30			5.00																	X				
SIGN SUMMARY SHEET							SHEET TOTALS	42.50	0.00	1	1	1	4	0	0	5	75.0			0	0.0	0.0	0.0	0.0	PROJECT NAME: STATEWIDE-SOUTH REGION				
								SF	SF	EA	EA	EA	EA	EA	EA	EA	FT			EA	LB	LB	LB	LB	PROJECT NUMBER: STPG SIGN(57)				
																											FILE NAME: z16t041Mt Holly103 NB.xls		
							VERMONT AGENCY OF TRANSPORTATION	TOWN DIRECTIONAL TOTALS	349.8	0.0	22	7	7	78	0	0	48	680.0			0	0.0				PLOT DATE: 2/27/2017			
																							DRAWN BY: W. GORDON						
																							CHECKED: BRZEZOWSKI						
																							DESIGNED BY: P. MCKECHNIE						
																							MOUNT HOLLY VT-103 NB 10						
																							SHEET 92 OF 264						