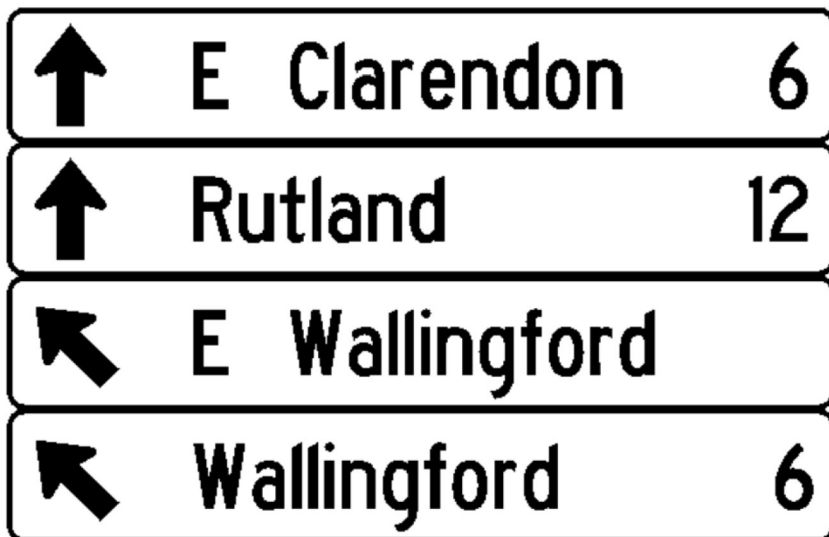


DIRECTION	MILEPOINT	LOCATION CODE (SHEET 4)	SIGN CODE	WIDTH (IN)	HEIGHT (IN)	SHEETING REMARKS	SIGN LEGEND	NEW SIGNS		EXISTING SIGNS				EXIST POST		NUMBER OF NEW POSTS	SQUARE STEEL (IN)			TUBULAR STEEL Ø (IN)				SIGN FRAME REQUIRED	REMARKS	SIGN DETAIL LOCATION					
								"A"	"B"	RETAIN	SALVAGE FROM	SALVAGE TO	REMOVE	RETAIN	REMOVE		1.75	2.00	2.50	FOUNDATION	3.00	3.50	4.00			5.00	SHSM	SIGN DETAILS SHEET #	STANDARD SHEET #		
																	(LB / FT)				(LB / FT)										
																	1.88	2.42	3.35		7.60	9.00	10.80			14.60					
NB MOUNT HOLLY VT ROUTE 103							FY-FLUORESCENT YELLOW FYG-FLUORESCENT YELLOW GREEN															"SHSM"-STANDARD HIGHWAY SIGNS AND MARKINGS BOOK									
NB	7.394	A	M2-1				 8/24/17			+			1	X																	
		A	VM1-5							+			1																		
		A	M2-1	21	15			2.19																INSTALL ON RETAINED POST JCT, GREEN ON WHITE	X						
		A	VM1-5	30	24			5.00																			E-136				
NB	7.455	A	VD1-1A				(UP) E. CLARENDON 6						1		X																
		A	VD1-1A				(UP) RUTLAND 14						1																		
		A	VD1-1				(UP AND LEFT) E. WALLINGFORD						1																		
		A	VD1-1A				(UP AND LEFT) WALLINGFORD 6						1																		
		A	VD1-1A	72	12		 12/1/17	6.00								2				14'-6" 13'-9" X						SLIP BASES REQUIRED SEE SHEET 4			T-93		
		A	VD1-1A	72	12			6.00																				T-93			
		A	VD1-1	72	12			6.00																				T-93			
		A	VD1-1A	72	12			6.00																				T-93			
NB	7.490	C	VR-017				 8/17/17						1	X											ROGER HILL RD (TH-10)						
		C	VR-017	24	30			5.00																	INSTALL ON RETAINED POST			T-70			
NB	7.490	AB	D3-1				ROGER HILL RD TH-10			1				X																	
SIGN SUMMARY SHEET							SHEET TOTALS	36.19	0.00	3	0	0	5	0	0	2		30.0		0	0.0	0.0	0.0	0.0	PROJECT NAME: STATEWIDE-SOUTH REGION	PROJECT NUMBER: STPG SIGN(57)					
								SF	SF	EA	EA	EA	EA	EA	EA	EA		FT		EA	LB	LB	LB	LB							
							VERMONT AGENCY OF TRANSPORTATION																					FILE NAME: z16t041Mt Hollv103 NB.xls	PLOT DATE: 2/27/2017		
							TOWN DIRECTIONAL TOTALS							349.8	0.0	22	7	7	78	0	0	48		680.0		0		0.0		DESIGNED BY: P. MCKECHNIE	DRAWN BY: W. GORDON
																							CHECKED: BRZEZOWSKI	SHEET 93 OF 264							