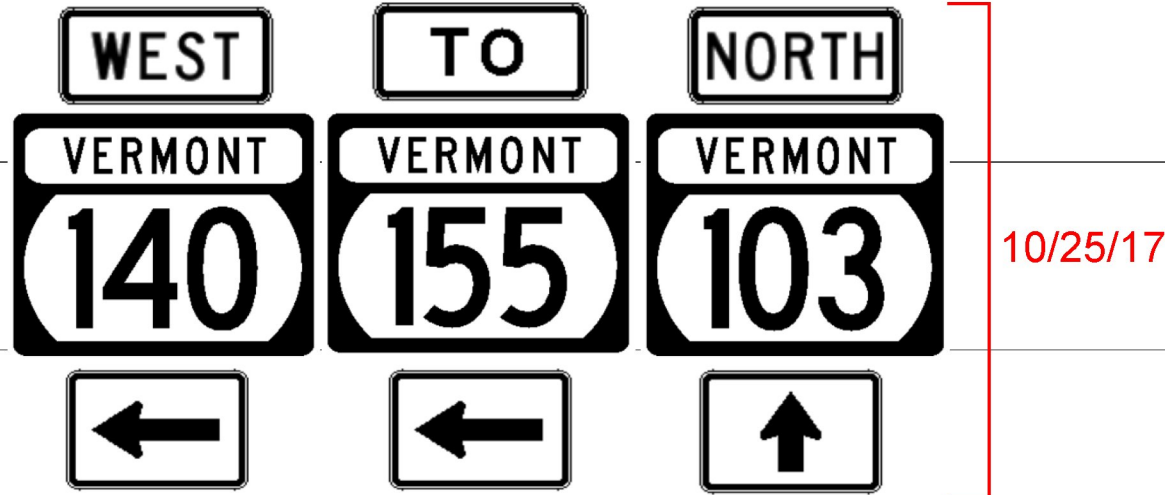
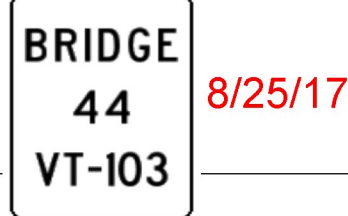


DIRECTION	MILEPOINT	LOCATION CODE (SHEET 4)	SIGN CODE	WIDTH (IN)	HEIGHT (IN)	SHEETING REMARKS	SIGN LEGEND	NEW SIGNS		EXISTING SIGNS				EXIST POST		NUMBER OF NEW POSTS	SQUARE STEEL (IN)			TUBULAR STEEL Ø (IN)				SIGN FRAME REQUIRED	REMARKS	SIGN DETAIL LOCATION			
								"A"	"B"	RETAIN	SALVAGE FROM	SALVAGE TO	REMOVE	RETAIN	REMOVE		1.75	2.00	2.50	FOUNDATION	3.00	3.50	4.00			5.00	SHSM	SIGN DETAILS SHEET #	STANDARD SHEET #
																	(LB / FT)				(LB / FT)								
																	1.88	2.42	3.35		7.60	9.00	10.80			14.60			
NB MOUNT HOLLY VT ROUTE 103							FY-FLUORESCENT YELLOW FYG-FLUORESCENT YELLOW GREEN															"SHSM"-STANDARD HIGHWAY SIGNS AND MARKINGS BOOK							
		A	M6-1L	21	15			2.19															ARROW, GREEN ON WHITE	X					
		A	M4-5	24	12			2.00															TO, GREEN ON WHITE	X					
		A	VM1-5	30	24			5.00																		E-136			
		A	M6-1L	21	15			2.19																ARROW, GREEN ON WHITE	X				
		A	M3-1	24	12			2.00																NORTH, GREEN ON WHITE	X				
		A	VM1-5	30	24			5.00																			E-136		
		A	M6-3	21	15			2.19																ARROW, GREEN ON WHITE	X				
NB	7.564	A	M3-1				NORTH			1				X															
		A	VM1-5				VERMONT 103			1																			
		A	VD-700				MILE MARKER 1030 / 1112 / 0760			1																			
NB	7.608	A	VD-701	6	10			0.42							1	7'-9" X											T-42		
SIGN SUMMARY SHEET							SHEET TOTALS	20.98	0.00	3	0	0	0	0	0	1	10.0			0	0.0	0.0	0.0	0.0	PROJECT NAME: STATEWIDE-SOUTH REGION				
								SF	SF	EA	EA	EA	EA	EA	EA	EA	FT			EA	LB	LB	LB	LB	PROJECT NUMBER: STPG SIGN(57)				
																										FILE NAME: z16t041Mt Holliv103 NB.xls			
VERMONT AGENCY OF TRANSPORTATION							TOWN DIRECTIONAL TOTALS	349.8	0.0	22	7	7	78	0	0	48	680.0			0	0.0				PLOT DATE: 2/27/2017				
																						DRAWN BY: W. GORDON							
																						DESIGNED BY: P. MCKECHNIE							
																						CHECKED BRZEZOWSKI							
																						MOUNT HOLLY VT-103 NB 13							
																						SHEET 95 OF 264							