
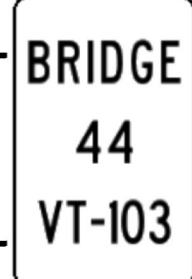




DIRECTION	MILEPOINT	LOCATION CODE (SHEET 4)	SIGN CODE	WIDTH (IN)	HEIGHT (IN)	SHEETING REMARKS	SIGN LEGEND	NEW SIGNS		EXISTING SIGNS			EXIST POST		NUMBER OF NEW POSTS	SQUARE STEEL (IN)			TUBULAR STEEL Ø (IN)				SIGN FRAME REQUIRED	REMARKS	SIGN DETAIL LOCATION				
								"A"	"B"	RETAIN	SALVAGE FROM	SALVAGE TO	REMOVE	RETAIN		REMOVE	1.75	2.00	2.50	FOUNDATION	3.00	3.50			4.00	5.00	SHSM	SIGN DETAILS SHEET #	STANDARD SHEET #
																	(LB / FT)				(LB / FT)								
<b>SB MOUNT HOLLY VT 103</b>							FY-FLUORESCENT YELLOW FYG-FLUORESCENT YELLOW GREEN															"SHSM"-STANDARD HIGHWAY SIGNS AND MARKINGS BOOK							
SB	7.624	F	M2-1				JCT																						
		F	VM1-5				VERMONT 140																						
		F	VD-701				BRIDGE / 44 / VT 103																						
		F	M2-1	21	15		 8/25/17	2.19														INSTALL ON RETAINED POST JCT, GREEN ON WHITE	X						
		F	VM1-5	30	24		 8/25/17	5.00																	E-136				
SB	7.619	F	VD-701	6	10			0.42						1	8'-6"	X									T-42				
SB	7.589	F	VD1-1A				(UP) MOUNT HOLLY 2																						
		F	VD1-1A				(UP) LUDLOW 11																						
		F	VD1-1A	72	12		 8/25/17	6.00														INSTALL ON RETAINED POSTS			T-93				
		F	VD1-1A	72	12		 8/25/17	6.00																	T-93				
SB	7.554	F	M3-3				SOUTH																						
		F	VM1-5				VERMONT 103																						
		F	M6-3				UP ARROW																						
		F	M3-4				WEST																						
		F	VM1-5				VERMONT 140																						
<b>SIGN SUMMARY SHEET</b>							<b>SHEET TOTALS</b>	19.60	0.00	0	0	0	10	0	0	1	10.0	0	0.0	0.0	0.0	0.0	PROJECT NAME: STATEWIDE-SOUTH REGION						
								SF	SF	EA	EA	EA	EA	EA	EA	EA	FT	EA	LB	LB	LB	LB	PROJECT NUMBER: STPG SIGN(57)						
VERMONT AGENCY OF TRANSPORTATION							<b>TOWN DIRECTIONAL TOTALS</b>	367.7	0.0	11	4	5	82	0	0	41	585.0	0		0.0			FILE NAME: z16t041Mt Holliv103 SB.xls	PLOT DATE: 2/27/2017					
																						PROJECT MANAGER: D. MUNRO	DRAWN BY: W. GORDON						
																						DESIGNED BY: P. MCKECHNIE	CHECKED: BRZEZOWSK						
																						MOUNT HOLLY VT-103 SB 1	SHEET 97	OF 264					