



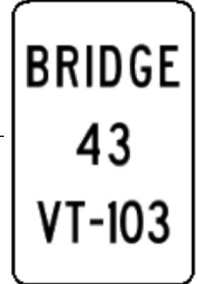

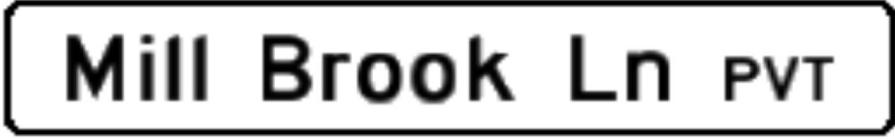

DIRECTION	MILEPOINT	LOCATION CODE (SHEET 4)	SIGN CODE	WIDTH (IN)	HEIGHT (IN)	SHEETING REMARKS	SIGN LEGEND	NEW SIGNS		EXISTING SIGNS			EXIST POST	NUMBER OF NEW POSTS	SQUARE STEEL (IN)			TUBULAR STEEL Ø (IN)				SIGN FRAME REQUIRED	REMARKS	SIGN DETAIL LOCATION					
								"A"	"B"	RETAIN	SALVAGE FROM	SALVAGE TO	REMOVE		RETAIN	REMOVE	1.75	2.00	2.50	FOUNDATION	3.00			3.50	4.00	5.00	SHSM	SIGN DETAILS SHEET #	STANDARD SHEET #
																	(LB / FT)				(LB / FT)								
SB MOUNT HOLLY VT 103							FY-FLUORESCENT YELLOW FYG-FLUORESCENT YELLOW GREEN														"SHSM"-STANDARD HIGHWAY SIGNS AND MARKINGS BOOK								
SB	7.104	F	VD-701				 8/24/17					1	X									INSTALL ON RETAINED POST			T-42				
		F	VD-701	6	10																								
SB	6.700	EF	D3-1				MILL BROOK LN PVT					1	X																
		EF	D3-1	72	12		8/21/17  6.00							2											7				
SB	6.599	F	W1-2L				 9/8/17 LEFT CURVE					1	X									INSTALL ON RETAINED POST	X						
		F	W1-2L	30	30																								
SB	6.584	G	VR-017				 8/18/17					1	X									N BOWLSVILLE RD (TH-17)							
		G	VR-017	24	30																	INSTALL ON RETAINED POST			T-70				
SB	6.574	H	R1-1				STOP					1	X																
		G	VD-700				MILE MARKER 1030 / 1112 / 0661			1																			
		H	R1-1	30	30		 8/18/17															INSTALL ON RETAINED POST	X						
SB	6.574	EF	D3-1				TH17 N Bowlsville Rd			1			X																
SB	6.484	F	W1-6L				LEFT ARROW BOARD					1	X																
		F	W1-6L	48	24		 8/24/17															INSTALL ON RETAINED POSTS	X						
SB	6.482	E	W1-6R				RIGHT ARROW BOARD					1	X																
SIGN SUMMARY SHEET							SHEET TOTALS	31.92	0.00	2	0	0	7	0	0	2	30.0	0	0.0	0.0	0.0	0.0	PROJECT NAME: STATEWIDE-SOUTH REGION PROJECT NUMBER: STPG SIGN(57)						
VERMONT AGENCY OF TRANSPORTATION							TOWN DIRECTIONAL TOTALS	367.7	0.0	11	4	5	82	0	0	41	585.0	0		0.0			FILE NAME: z16t041Mt Holly103 SB.xls PROJECT MANAGER: D. MUNRO DESIGNED BY: P. MCKECHNIE MOUNT HOLLY VT-103 SB 3	PLOT DATE: 2/27/2017 DRAWN BY: W. GORDON CHECKED: BRZEZOWSK SHEET 99 OF 264					