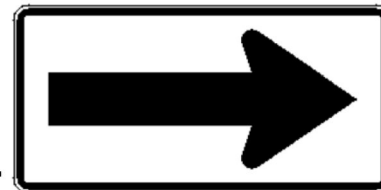
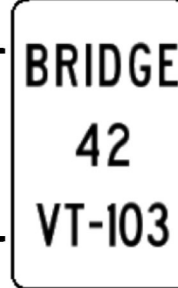
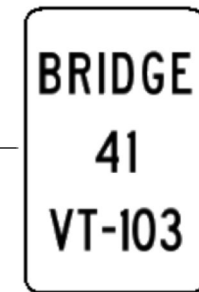
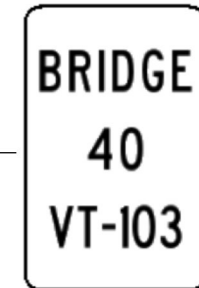


DIRECTION	MILEPOINT	LOCATION CODE (SHEET 4)	SIGN CODE	WIDTH (IN)	HEIGHT (IN)	SHEETING REMARKS	SIGN LEGEND	NEW SIGNS		EXISTING SIGNS				EXIST POST		NUMBER OF NEW POSTS	SQUARE STEEL (IN)			TUBULAR STEEL Ø (IN)				SIGN FRAME REQUIRED	REMARKS	SIGN DETAIL LOCATION			
								"A"	"B"	RETAIN	SALVAGE FROM	SALVAGE TO	REMOVE	RETAIN	REMOVE		1.75	2.00	2.50	FOUNDATION	3.00	3.50	4.00			5.00	SHSM	SIGN DETAILS SHEET #	STANDARD SHEET #
																	(LB / FT)				(LB / FT)								
																	1.88	2.42	3.35		7.60	9.00	10.80			14.60			
SB MOUNT HOLLY VT 103							FY-FLUORESCENT YELLOW FYG-FLUORESCENT YELLOW GREEN															"SHSM"-STANDARD HIGHWAY SIGNS AND MARKINGS BOOK							
		E	W1-6R	48	24		 8/22/17	8.00							2		12'-0" 12'-0" X							INSTALL ±10 FT DOWN STATION OF EXISTING SIGN AT MP 6.482 NB	X				
SB	6.169	E	W5-2				 8/22/17						1	X															
		E	VW-619	30	30				6.25																INSTALL ON RETAINED POST			T-82	
SB	6.025	F	VD-701	6	10		 9/7/17	0.42							1		8'-3" X										T-42		
SB	6.024	F	OM3-R										1		X														
		F	VD-701										1																
		F	OM3-R	12	36		 9/7/17	3.00							1		10'-6" X								X				
SB	6.014	E	OM3-L	12	36		 9/7/17	3.00							1		10'-9" X								X				
SB	5.904	F	VD-701				 8/23/17						1	X															
		F	VD-701	6	10			0.42																INSTALL ON RETAINED POST			T-42		
SB	5.464	F	VD-701				 8/23/17						1	X															
		F	VD-701	6	10			0.42																INSTALL ON RETAINED POST			T-42		
SB	5.424	F	VD-062B				OFFICIAL BUSINESS DIRECTIONAL SIGN			1				X										Village Baptist Church					
SB	5.384	F	W11-8				EMERGENCY VEHICLE						1	X	X									REMOVE LEFT POST RETAIN RIGHT POST					
		F	VD-700				MILE MARKER 1030 / 1112 / 0540				1	1																	
SIGN SUMMARY SHEET							SHEET TOTALS	21.50	0.00	1	1	0	7	0	0	5		70.0		0	0.0	0.0	0.0	0.0	PROJECT NAME: STATEWIDE-SOUTH REGION				
								SF	SF	EA	EA	EA	EA	EA	EA	EA		FT		EA	LB	LB	LB	LB	PROJECT NUMBER: STPG SIGN(57)				
																									FILE NAME: z16t041Mt Hollv103 SB.xls				
VERMONT AGENCY OF TRANSPORTATION							TOWN DIRECTIONAL TOTALS	367.7	0.0	11	4	5	82	0	0	41		585.0		0	0.0				PLOT DATE: 2/27/2017				
																								DESIGNED BY: P. MCKECHNIE	DRAWN BY: W. GORDON				
																								CHECKED BRZEZOWSKI					
																								MOUNT HOLLY VT-103 SB 4	SHEET 100 OF 264				