
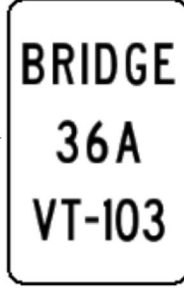
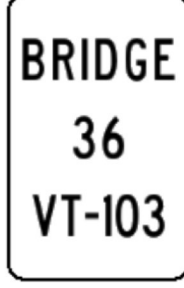


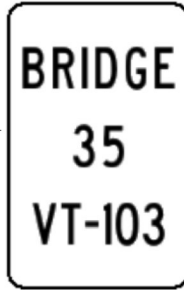


DIRECTION	MILEPOINT	LOCATION CODE (SHEET 4)	SIGN CODE	WIDTH (IN)	HEIGHT (IN)	SHEETING REMARKS	SIGN LEGEND	NEW SIGNS		EXISTING SIGNS			EXIST POST		NUMBER OF NEW POSTS	SQUARE STEEL (IN)			TUBULAR STEEL Ø (IN)				SIGN FRAME REQUIRED	REMARKS	SIGN DETAIL LOCATION				
								"A"	"B"	RETAIN	SALVAGE FROM	SALVAGE TO	REMOVE	RETAIN		REMOVE	1.75	2.00	2.50	FOUNDATION	3.00	3.50			4.00	5.00	SHSM	SIGN DETAILS SHEET #	STANDARD SHEET #
																	(LB / FT)				(LB / FT)								
SB MOUNT HOLLY VT 103							FY-FLUORESCENT YELLOW FYG-FLUORESCENT YELLOW GREEN															"SHSM"-STANDARD HIGHWAY SIGNS AND MARKINGS BOOK							
		F	M6-1R	21	15			2.19															RIGHT ARROW, WHITE ON BLUE	X					
SB	3.874	F	VD-701				 11/29/17					1	X	X															
		F	VD-701	6	10			0.42						1	8'-3" X								INSTALL ON RETAINED POST			T-42			
SB	3.569	F	VD-701				 8/22/17					1	X										INSTALL ON RETAINED POST			T-42			
		F	VD-701	6	10			0.42																					
SB	3.219	F	VD-701				 8/22/17					1	X										INSTALL ON RETAINED POST			T-42			
		F	VD-701	6	10			0.42																					
SB	2.800	F	VD-700				8/22/17 MILE MARKER 1030 / 1112 / 0280				1			1	7'-9" X											T-44			
SB	2.729	F	VW-092				UNSAFE TO PASS					1		X															
		F	VD-700				MILE MARKER 1030 / 1112 / 0280				1	1																	
		F	VW-092	30	30		 8/22/17	6.25						1	14'-9" X											T-81			
SB	2.484	F	VW-092				 8/22/17					1	X	X									REMOVE LEFT POST RETAIN RIGHT POST						
		F	VW-092	30	30			6.25															INSTALL ON RETAINED POST			T-81			
SB	2.434	F	R2-1				 8/22/17					1	X																
		F	R2-1	24	30			5.00															INSTALL ON RETAINED POST	X					
SIGN SUMMARY SHEET							SHEET TOTALS	20.94	0.00	0	1	1	7	0	0	2	25.0	0	0.0	0.0	0.0	0.0	PROJECT NAME: STATEWIDE-SOUTH REGION PROJECT NUMBER: STPG SIGN(57)						
VERMONT AGENCY OF TRANSPORTATION							TOWN DIRECTIONAL TOTALS	367.7	0.0	11	4	5	82	0	0	41	585.0	0		0.0			FILE NAME: z16t041Mt Hollv103 SB.xls PROJECT MANAGER: D. MUNRO DESIGNED BY: P. MCKECHNIE MOUNT HOLLY VT-103 SB 8	PLOT DATE: 2/27/2017 DRAWN BY: W. GORDON CHECKED: BRZEZOWSK SHEET 104 OF 264					