




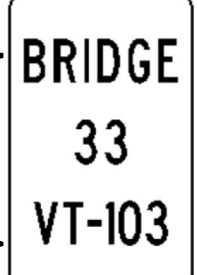




DIRECTION	MILEPOINT	LOCATION CODE (SHEET 4)	SIGN CODE	WIDTH (IN)	HEIGHT (IN)	SHEETING REMARKS	SIGN LEGEND	NEW SIGNS		EXISTING SIGNS			EXIST POST		NUMBER OF NEW POSTS	SQUARE STEEL (IN)			TUBULAR STEEL Ø (IN)				SIGN FRAME REQUIRED	REMARKS	SIGN DETAIL LOCATION				
								"A"	"B"	RETAIN	SALVAGE FROM	SALVAGE TO	REMOVE	RETAIN		REMOVE	1.75	2.00	2.50	FOUNDATION	3.00	3.50			4.00	5.00	SHSM	SIGN DETAILS SHEET #	STANDARD SHEET #
																	(LB / FT)				(LB / FT)								
SB MOUNT HOLLY VT 103							FY-FLUORESCENT YELLOW FYG-FLUORESCENT YELLOW GREEN															"SHSM"-STANDARD HIGHWAY SIGNS AND MARKINGS BOOK							
		F	M3-3	24	12		 8/18/17	2.00														INSTALL ON RETAINED POST SOUTH, GREEN ON WHITE	X						
		F	VM1-5	24	24			4.00																	E-136				
SB	1.494	F	R2-1				 8/18/17					1	X									INSTALL ON RETAINED POSTS	X						
		F	R2-1	24	30			5.00																					
SB	1.129	EF	D3-1				GREENSTAND RD			1				X								GREENSTAND RD (TH-43)							
SB	1.129	G	VR-017	24	30		 8/14/17	5.00							1		13'-6"	X				INSTALL NEW SIGN ON LEGAL LOAD SIDE OF INTERSECTION			T-70				
SB	1.119	H	R1-1				STOP					1	X																
		G	VD-700				MILE MARKER 1030 / 1112 / 0114			1																			
		H	R1-1	30	30		 8/14/17	6.25														INSTALL ON RETAINED POST	X						
SB	1.050	F	VD-701	6	10		 9/2/17	0.42							1		7'-3"	X							T-42				
SB	1.049	F	OM3-R				RIGHT OBJECT MARKER					1	X																
		F	VD-701				BRIDGE / 33 / VT103					1																	
		F	OM3-R	12	36		 9/7/17	3.00							1		10'-9"	X					X						
SB	1.029	E	OM3-L				 9/7/17					1	X																
		E	OM3-L	12	36			3.00							1		10'-6"	X					X						
SIGN SUMMARY SHEET							SHEET TOTALS	28.67	0.00	2	0	0	5	0	0	4	55.0	0	0.0	0.0	0.0	0.0	PROJECT NAME: STATEWIDE-SOUTH REGION PROJECT NUMBER: STPG SIGN(57)						
VERMONT AGENCY OF TRANSPORTATION							TOWN DIRECTIONAL TOTALS	367.7	0.0	11	4	5	82	0	0	41	585.0	0		0.0			FILE NAME: z16t041Mt Holly103 SB.xls PROJECT MANAGER: D. MUNRO DESIGNED BY: P. MCKECHNIE MOUNT HOLLY VT-103 SB 11	PLOT DATE: 2/27/2017 DRAWN BY: W. GORDON CHECKED: BRZEZOWSK SHEET 107 OF 264					