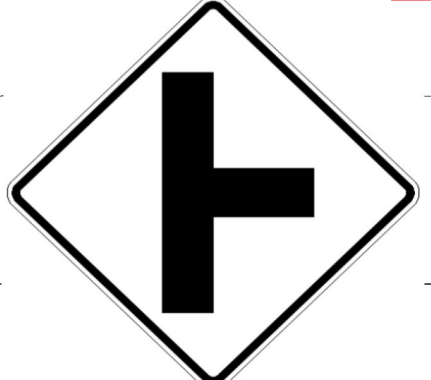




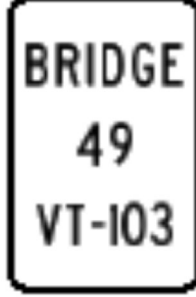



DIRECTION	MILEPOINT	LOCATION CODE (SHEET 4)	SIGN CODE	WIDTH (IN)	HEIGHT (IN)	SHEETING REMARKS	SIGN LEGEND	NEW SIGNS		EXISTING SIGNS			EXIST POST		NUMBER OF NEW POSTS	SQUARE STEEL (IN)			TUBULAR STEEL Ø (IN)				SIGN FRAME REQUIRED	REMARKS	SIGN DETAIL LOCATION				
								"A"	"B"	RETAIN	SALVAGE FROM	SALVAGE TO	REMOVE	RETAIN		REMOVE	1.75	2.00	2.50	FOUNDATION	3.00	3.50			4.00	5.00	SHSM	SIGN DETAILS SHEET #	STANDARD SHEET #
																	(LB / FT)				(LB / FT)								
NB WALLINGFORD VT RTE 103							FY-FLUORESCENT YELLOW FYG-FLUORESCENT YELLOW GREEN															"SHSM"-STANDARD HIGHWAY SIGNS AND MARKINGS BOOK							
NB	1.616	A	W2-2M				T-INTERSECTION					1	X																
		A	W16-8P				OLD TURNPIKE RD					1																	
		A	W2-2	36	36		 9/14/17	9.00														INSTALL ON RETAINED POSTS	X						
		A	W16-8P	36	8		 9/14/17	2.00																5					
NB	1.701	C	VR-017				 9/11/17					1	X									OLD TURNPIKE RD (TH-26)							
		C	VR-017	24	30			5.00														INSTALL ON RETAINED POST			T-70				
NB	1.701	AB	D3-1	68	12		 9/13/17	5.67						2		11'-0" 10'-6" X						INSTALL INDEPENDENTLY ON TWO POSTS ON LEGAL LOAD SIDE OF THE INTERSECTION		7					
NB	1.711	AB	D3-1				OLD TURNPIKE RD					1	X																
		D	R1-1				STOP					1																	
		C	VD-700				MILE MARKER 1030 / 1125 / 0174			1																			
		D	R1-1	30	30		 9/11/17	6.25														INSTALL ON RETAINED POST	X						
NB	1.721	A	VD-701				 11/28/17					1		X															
		A	VD-701	6	10			0.42						1		7'-9" X									T-42				
NB	1.806	C	VR-017				 9/12/17					1	X									STOCKER LN (TH-76)							
		C	VR-017	24	30			5.00														INSTALL ON RETAINED POST			T-70				
SIGN SUMMARY SHEET							SHEET TOTALS	33.33	0.00	1	0	0	7	0	0	3	40.0	0	0.0	0.0	0.0	0.0	PROJECT NAME: STATEWIDE-SOUTH REGION PROJECT NUMBER: STPG SIGN(57)						
VERMONT AGENCY OF TRANSPORTATION							TOWN DIRECTIONAL TOTALS	173.8	0.0	14	1	1	33	0	0	23	335.0	0		0.0		FILE NAME: z16t041Wallinaford103 NB.xls PLOT DATE: 2/27/2017 PROJECT MANAGER: D. MUNRO DRAWN BY: W. GORDON DESIGNED BY: P. MCKECHNIE CHECKED: BRZEZOWSKA WALLINGFORD VT-103 NB 5 SHEET 114 OF 264							