



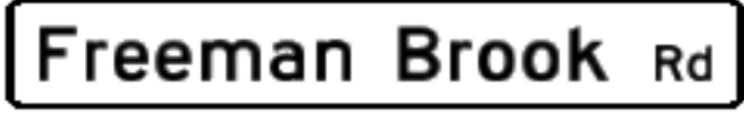



DIRECTION	MILEPOINT	LOCATION CODE (SHEET 4)	SIGN CODE	WIDTH (IN)	HEIGHT (IN)	SHEETING REMARKS	SIGN LEGEND	NEW SIGNS		EXISTING SIGNS				EXIST POST		NUMBER OF NEW POSTS	SQUARE STEEL (IN)			TUBULAR STEEL Ø (IN)				SIGN FRAME REQUIRED	REMARKS	SIGN DETAIL LOCATION						
								"A"	"B"	RETAIN	SALVAGE FROM	SALVAGE TO	REMOVE	RETAIN	REMOVE		1.75	2.00	2.50	FOUNDATION	3.00	3.50	4.00			5.00	SHSM	SIGN DETAILS SHEET #	STANDARD SHEET #			
																	(LB / FT)				(LB / FT)											
NB WALLINGFORD VT RTE 103							FY-FLUORESCENT YELLOW FYG-FLUORESCENT YELLOW GREEN																"SHSM"-STANDARD HIGHWAY SIGNS AND MARKINGS BOOK									
NB	1.808	AB	D3-1	42	12		 Stockers Ln 9/13/17	3.50							+		*								INSTALLED ON TOP OF STOP SIGN		7					
NB	1.816	D	R1-1	30	30		 9/12/17	6.25							1		11'-0"	X									X					
NB	1.816	C	VR-017				 LLL 24,000 LBS 9/12/17																									
		C	VR-017	24	30			5.00																					T-70			
NB	1.820	AB	D3-1				FREEMAN BROOK RD																									
		D	R1-1																													
		C	VD-700				 9/12/17																									
		D	R1-1	30	30		MILE MARKER 1030 / 1125 / 0200	6.25							1		12'-3"	X									X					
		C	VD-700				MILE MARKER 1030 / 1125 / 0200																									
NB	1.820	AB	D3-1	72	12		 Freeman Brook Rd 10/27/17	6.00							2		11'-0"	10'-3"	X										INSTALL INDEPENDENTLY ON TWO POSTS 10' FROM STOP SIGN		7	
NB	1.911	A	W1-2R				 9/12/17																									
		A	W1-2R	30	30			6.25							1		13'-3"	X									X					
SIGN SUMMARY SHEET							SHEET TOTALS	33.25	0.00	0	1	1	5	0	0	6	90.0	0	0.0	0.0	0.0	0.0	0.0	0.0	0.0	PROJECT NAME: STATEWIDE-SOUTH REGION PROJECT NUMBER: STPG SIGN(57)						
VERMONT AGENCY OF TRANSPORTATION							TOWN DIRECTIONAL TOTALS	173.8	0.0	14	1	1	33	0	0	23	335.0	0				0.0				FILE NAME: z16t041Wallinaford103 NB.xls PLOT DATE: 2/27/2017 PROJECT MANAGER: D. MUNRO DRAWN BY: W. GORDON DESIGNED BY: P. MCKECHNIE CHECKED: BRZEZOWSK WALLINGFORD VT-103 NB 6 SHEET 115 OF 264						