

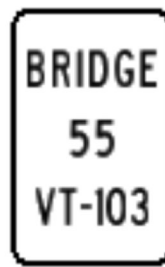
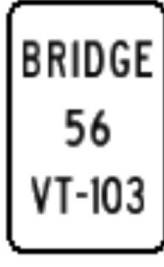




DIRECTION	MILEPOINT	LOCATION CODE (SHEET 4)	SIGN CODE	WIDTH (IN)	HEIGHT (IN)	SHEETING REMARKS	SIGN LEGEND	NEW SIGNS		EXISTING SIGNS			EXIST POST		NUMBER OF NEW POSTS	SQUARE STEEL (IN)			TUBULAR STEEL Ø (IN)				SIGN FRAME REQUIRED	REMARKS	SIGN DETAIL LOCATION				
								"A"	"B"	RETAIN	SALVAGE FROM	SALVAGE TO	REMOVE	RETAIN		REMOVE	1.75	2.00	2.50	FOUNDATION	3.00	3.50			4.00	5.00	SHSM	SIGN DETAILS SHEET #	STANDARD SHEET #
																	(LB / FT)				(LB / FT)								
NB CLARENDON VT ROUTE 103							FY-FLUORESCENT YELLOW FYG-FLUORESCENT YELLOW GREEN															"SHSM"-STANDARD HIGHWAY SIGNS AND MARKINGS BOOK							
NB	1.123	A	VD-701	6	10		 11/28/17	0.42						1	8'-6" X								INSTALL 10' SOUTH OF EXISTING SB BRIDGE PLAQUE AT MP 1.138 SB			T-42			
NB	1.158	C	VR-023b				 10/16/17					1	X										INSTALL ON RETAINED POST			T-70			
NB	1.238	A	VD-701				 10/16/17					1	X										INSTALL ON RETAINED POST			T-42			
NB	1.386	A	VD-062B				OFFICIAL BUSINESS DIRECTIONAL SIGN		1				X										Airport Industrial Park, Left on 7B						
		A	VD-062B				OFFICIAL BUSINESS DIRECTIONAL SIGN		1														Cape Air Jet Blue Airways						
NB	1.406	A	VD-701				 10/17/17					1	X		7'-9" X											T-42			
NB	1.434	A					RUTLAND SOUTHERN VERMONT REGIONAL AIRPORT <---		1				X																
NB	1.439	C	W14-2				NO OUTLET		1				X																
		C					SERVICE ROAD		1																				
NB	1.629	A	W2-1				 10/16/17					1	X																
		A	W13-1P				40 M.P.H.					1																	
		A	W2-1	30	30			6.25															THINNING AND TRIMMING INSTALL ON RETAINED POST	X					
SIGN SUMMARY SHEET							SHEET TOTALS	12.50	0.00	5	0	0	5	0	0	2	20.0	0	0.0	0.0	0.0	0.0		PROJECT NAME: STATEWIDE-SOUTH REGION PROJECT NUMBER: STPG SIGN(57)					
VERMONT AGENCY OF TRANSPORTATION							TOWN DIRECTIONAL TOTALS	182.0	0.0	16	2	2	53	0	0	14	200.0	0		0.0				FILE NAME: z16t041Clarendon103 NB.xls PROJECT MANAGER: D. MUNRO DESIGNED BY: P. MCKECHNIE CLARENDON VT-103 NB 3	PLOT DATE: 2/27/2017 DRAWN BY: W. GORDON CHECKED: BRZEZOWSK SHEET 136 OF 264				