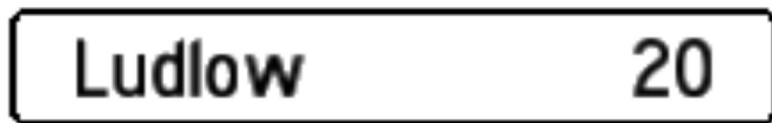


DIRECTION	MILEPOINT	LOCATION CODE (SHEET 4)	SIGN CODE	WIDTH (IN)	HEIGHT (IN)	SHEETING REMARKS	SIGN LEGEND	NEW SIGNS		EXISTING SIGNS				EXIST POST		NUMBER OF NEW POSTS	SQUARE STEEL (IN)			TUBULAR STEEL Ø (IN)				SIGN FRAME REQUIRED	REMARKS	SIGN DETAIL LOCATION			
								"A"	"B"	RETAIN	SALVAGE FROM	SALVAGE TO	REMOVE	RETAIN	REMOVE		1.75	2.00	2.50	FOUNDATION	3.00	3.50	4.00			5.00	SHSM	SIGN DETAILS SHEET #	STANDARD SHEET #
																	(LB / FT)				(LB / FT)								
																	1.88	2.42	3.35		7.60	9.00	10.80			14.60			
SB CLARENDON VT ROUTE 103							FY-FLUORESCENT YELLOW FYG-FLUORESCENT YELLOW GREEN															"SHSM"-STANDARD HIGHWAY SIGNS AND MARKINGS BOOK							
SB	1.960	F	R1-2				 11/28/17							1		X													
		F	R1-2	36	36			3.90						1			12'-3" X							36"X36"X36"	X				
SB	1.930	F	VD1-1A										1	X															
		F	VD2-1	72	12		 10/16/17	6.00																INSTALL ON RETAINED POST			T-93		
SB	1.906	F	W2-1										1	X															
		F	W13-1P				 10/16/17						1																
		F	W2-1	30	30		 10/17/17	6.25																INSTALL ON RETAINED POST	X				
		F	W13-1P	18	18			2.25																	X				
SB	1.886	F	M2-1										1	X															
		F	VM1-5										1																
		F	M2-1	21	15		 10/16/17	2.19																INSTALL ON RETAINED POST JCT, GREEN ON WHITE	X				
		F	VM1-5	24	24			4.00																		E-136			
SB	1.856	F	VD-062B				OFFICIAL BUSINESS DIRECTIONAL SIGN			1				X										Airport Industrial Park, Left on 7B					
		F	VD-062B				OFFICIAL BUSINESS DIRECTIONAL SIGN			1														Cape Air Jet Blue Airways					
SB	1.798	F	M3-1				NORTH						1		X														
SIGN SUMMARY SHEET							SHEET TOTALS	24.59	0.00	2	0	0	7	0	0	1		15.0		0	0.0	0.0	0.0	0.0	PROJECT NAME: STATEWIDE-SOUTH REGION				
								SF	SF	EA	EA	EA	EA	EA	EA	EA		FT		EA	LB	LB	LB	LB	PROJECT NUMBER: STPG SIGN(57)				
																										FILE NAME: z16t041Clarendon103 SB.xls			
																										PLOT DATE: 2/27/2017			
VERMONT AGENCY OF TRANSPORTATION							TOWN DIRECTIONAL TOTALS	142.7	0.0	4	1	1	34	0	0	13		185.0		0		0.0		DRAWN BY: W. GORDON					
																									CHECKED: BRZEZOWSKI				
																							DESIGNED BY: P. MCKECHNIE						
																							CLARENDON VT-103 SB 1						
																							SHEET 143 OF 264						