







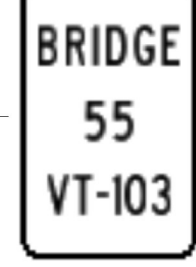
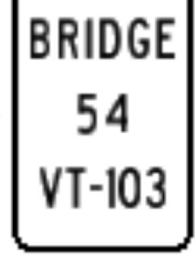


DIRECTION	MILEPOINT	LOCATION CODE (SHEET 4)	SIGN CODE	WIDTH (IN)	HEIGHT (IN)	SHEETING REMARKS	SIGN LEGEND	NEW SIGNS		EXISTING SIGNS			EXIST POST		NUMBER OF NEW POSTS	SQUARE STEEL (IN)			TUBULAR STEEL Ø (IN)				SIGN FRAME REQUIRED	REMARKS	SIGN DETAIL LOCATION				
								"A"	"B"	RETAIN	SALVAGE FROM	SALVAGE TO	REMOVE	RETAIN		REMOVE	1.75	2.00	2.50	FOUNDATION	3.00	3.50			4.00	5.00	SHSM	SIGN DETAILS SHEET #	STANDARD SHEET #
																	(LB / FT)				(LB / FT)								
SB CLARENDON VT ROUTE 103							FY-FLUORESCENT YELLOW FYG-FLUORESCENT YELLOW GREEN															"SHSM"-STANDARD HIGHWAY SIGNS AND MARKINGS BOOK							
SB	1.555	F	VR-921R	30	30		 10/17/17	6.25							1	13'-6" X							INSTALL SIGN 175' UPSTATION FROM EXISTING SIGN AT MP 1.522 SB AT BEGINNING OF SOLID WHITE LINE			E-145			
SB	1.522	F					 10/17/17				1												RUTLAND SOUTHERN VERMONT REGIONAL AIRPORT ->						
		F	D4-2R				 10/16/17				1												PARK & RIDE ->						
SB	1.483	G	VR-079	24	30		 10/16/17	5.00							1	12'-9" X							AIRPORT RD (TH-7) INSTALL ON LEGAL LOAD SIDE OF INTERSECTION			T-71			
SB	1.472	H	R1-1				 10/16/17					1																	
		F	D3-1	42	12		 10/16/17	3.50							1	12'-9" X							INSTALL ON TOP OF STOP SIGN		8				
		H	R1-1	30	30			6.25														X							
SB	1.415	F	VD-701				 10/16/17					1																	
		F	VD-701	6	10			0.42							1	7'-9" X										T-42			
SB	1.262	F	VW-202				 10/16/17					1																	
		F	VW-202	30	30			6.25															INSTALL ON RETAINED POST			T-81			
SB	1.253	F	VD-701				 10/16/17					1																	
		F	VD-701	6	10			0.42															INSTALL ON RETAINED POST			T-42			
SB	1.138	F	VD-701				 10/16/17					1																	
		F	VD-701	6	10			0.42															INSTALL ON RETAINED POST			T-42			
SIGN SUMMARY SHEET							SHEET TOTALS	28.50	0.00	2	0	0	5	0	0	4	55.0	0	0.0	0.0	0.0	0.0	PROJECT NAME: STATEWIDE-SOUTH REGION PROJECT NUMBER: STPG SIGN(57)						
VERMONT AGENCY OF TRANSPORTATION								SF	SF	EA	EA	EA	EA	EA	EA	EA	FT	EA	LB	LB	LB	LB	FILE NAME: z16t041Clarendon103 SB.xls PROJECT MANAGER: D. MUNRO DESIGNED BY: P. MCKECHNIE CLARENDON VT-103 SB 4	PLOT DATE: 2/27/2017 DRAWN BY: W. GORDON CHECKED: BRZEZOWSKA SHEET 146 OF 264					
							TOWN DIRECTIONAL TOTALS	142.7	0.0	4	1	1	34	0	0	13	185.0	0		0.0									