




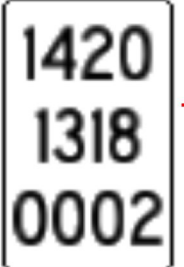


DIRECTION	MILEPOINT	LOCATION CODE (SHEET 4)	SIGN CODE	WIDTH (IN)	HEIGHT (IN)	SHEETING REMARKS	SIGN LEGEND	NEW SIGNS		EXISTING SIGNS			EXIST POST		NUMBER OF NEW POSTS	SQUARE STEEL (IN)			TUBULAR STEEL Ø (IN)				SIGN FRAME REQUIRED	REMARKS	SIGN DETAIL LOCATION				
								"A"	"B"	RETAIN	SALVAGE FROM	SALVAGE TO	REMOVE	RETAIN		REMOVE	1.75	2.00	2.50	FOUNDATION	3.00	3.50			4.00	5.00	SHSM	SIGN DETAILS SHEET #	STANDARD SHEET #
																	(LB / FT)				(LB / FT)								
NB VERNON VT ROUTE 142							FY-FLUORESCENT YELLOW FYG-FLUORESCENT YELLOW GREEN															"SHSM"-STANDARD HIGHWAY SIGNS AND MARKINGS BOOK							
NB	0.000	C	VR-017				LLL 24,000 LBS																OLD DEPOT RD (TH-23)						
		C	R2-1				SPEED LIMIT 25				1												SALVAGE SIGN ON NEW POST AT SAME STATION BELOW LEGAL LOAD						
		C	VR-017	24	30		 11/14/17	5.00																		T-70			
		C	R2-1				SPEED LIMIT 25																						
NB	0.006	D	R1-1				 11/14/17																OLD DEPOT RD (TH-23)						
		D	R1-1	30	30			6.25																X					
NB	0.006	A	VD-700				MILE MARKER 1420 / 1318 / 0000																						
NB	0.006	A	VR-039				STATE HIGHWAY BEGINS																						
		B	VR-038				STATE HIGHWAY ENDS																						
		A	R2-1				SPEED LIMIT 40																						
		A	VR-039	24	18		  11/14/17	3.00																		T-71			
		B	VR-038	24	18		 11/14/17	3.00																		T-71			
		A	R2-1	24	30			5.00																X					
		A	VD-700	6	10		 -4/9/18	0.42																		T-44			
NB	0.008	AB					OLD DEPOT RD																						
SIGN SUMMARY SHEET							SHEET TOTALS	22.67	0.00	0	1	1	7	0	0	3	45.0	0	0.0	0.0	0.0	0.0	PROJECT NAME: STATEWIDE-SOUTH REGION PROJECT NUMBER: STPG SIGN(57)						
VERMONT AGENCY OF TRANSPORTATION							TOWN DIRECTIONAL TOTALS	615.1	0.0	21	16	16	132	0	0	110	1630.0	0			0.0	FILE NAME: z16t041Vernon142 NB.xls PROJECT MANAGER: D. MUNRO DESIGNED BY: P. MCKECHNIE VERNON VT-142 NB 1	PLOT DATE: 2/27/2017 DRAWN BY: W. GORDON CHECKED: BRZEZOWSKA SHEET 149 OF 264						