





 




DIRECTION	MILEPOINT	LOCATION CODE (SHEET 4)	SIGN CODE	WIDTH (IN)	HEIGHT (IN)	SHEETING REMARKS	SIGN LEGEND	NEW SIGNS		EXISTING SIGNS				EXIST POST		NUMBER OF NEW POSTS	SQUARE STEEL (IN)			TUBULAR STEEL Ø (IN)				SIGN FRAME REQUIRED	REMARKS	SIGN DETAIL LOCATION						
								"A"	"B"	RETAIN	SALVAGE FROM	SALVAGE TO	REMOVE	RETAIN	REMOVE		1.75	2.00	2.50	FOUNDATION	3.00	3.50	4.00			5.00	SHSM	SIGN DETAILS SHEET #	STANDARD SHEET #			
																	(LB / FT)				(LB / FT)											
NB VERNON VT ROUTE 142							FY-FLUORESCENT YELLOW FYG-FLUORESCENT YELLOW GREEN															"SHSM"-STANDARD HIGHWAY SIGNS AND MARKINGS BOOK										
NB	0.120	A	W12-2	36	36	FY	 	9.00																16'-6" 15'-3" X				INSTALL 400' UPSTATION FROM WELCOME TO VERMONT SIGN AT 0.044 NB.	X			
		A		24	18	FY			3.00																					5		
NB	0.165	A	W11-7				 																									
		A	W7-3aP																													
		A	W11-4	30	30				6.25																							
		A	W7-3aP	24	18			3.00																								
NB	0.205	A	W11-5	30	30		 	6.25																								
		A	W7-3aP	24	18				3.00																							
NB	0.223	A																														
		A																														
NB	0.245	A	W11-5																													
		A	W7-3aP																													
		A	VR-654	24	24				4.00																						T-73	
NB	0.363	A	VW-362P																													
		A	R2-1																													
SIGN SUMMARY SHEET							SHEET TOTALS	34.50	0.00	2	0	0	6	0	0	5	75.0	0	0.0	0.0	0.0	0.0	0.0	PROJECT NAME: STATEWIDE-SOUTH REGION PROJECT NUMBER: STPG SIGN(57)								
VERMONT AGENCY OF TRANSPORTATION							TOWN DIRECTIONAL TOTALS	615.1	0.0	21	16	16	132	0	0	110	1630.0	0		0.0				FILE NAME: z16t041Vernon142 NB.xls PROJECT MANAGER: D. MUNRO DESIGNED BY: P. MCKECHNIE VERNON VT-142 NB 3	PLOT DATE: 2/27/2017 DRAWN BY: W. GORDON CHECKED: BRZEZOWSK SHEET 151 OF 264							