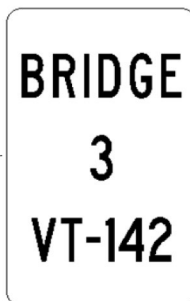


| DIRECTION              | MILEPOINT | LOCATION CODE (SHEET 4) | SIGN CODE | WIDTH (IN) | HEIGHT (IN) | SHEETING REMARKS        | SIGN LEGEND                                                                                  | NEW SIGNS |      | EXISTING SIGNS |              |            |        | EXIST POST |        | NUMBER OF NEW POSTS | SQUARE STEEL<br>(IN)  |             |      | TUBULAR STEEL<br>Ø (IN) |           |                                                    |       | SIGN FRAME REQUIRED                                | REMARKS                                               | SIGN DETAIL LOCATION |      |                                  |                     |
|------------------------|-----------|-------------------------|-----------|------------|-------------|-------------------------|----------------------------------------------------------------------------------------------|-----------|------|----------------|--------------|------------|--------|------------|--------|---------------------|-----------------------|-------------|------|-------------------------|-----------|----------------------------------------------------|-------|----------------------------------------------------|-------------------------------------------------------|----------------------|------|----------------------------------|---------------------|
|                        |           |                         |           |            |             |                         |                                                                                              | "A"       | "B"  | RETAIN         | SALVAGE FROM | SALVAGE TO | REMOVE | RETAIN     | REMOVE |                     | 1.75                  | 2.00        | 2.50 | FOUNDATION              | 3.00      | 3.50                                               | 4.00  |                                                    |                                                       | 5.00                 | SHSM | SIGN DETAILS<br>SHEET #          | STANDARD<br>SHEET # |
|                        |           |                         |           |            |             |                         |                                                                                              |           |      |                |              |            |        |            |        |                     | (LB / FT)             |             |      |                         | (LB / FT) |                                                    |       |                                                    |                                                       |                      |      |                                  |                     |
|                        |           |                         |           |            |             |                         |                                                                                              |           |      |                |              |            |        |            |        |                     | 1.88                  | 2.42        | 3.35 |                         | 7.60      | 9.00                                               | 10.80 |                                                    |                                                       | 14.60                |      |                                  |                     |
| NB VERNON VT ROUTE 142 |           |                         |           |            |             |                         | FY-FLUORESCENT YELLOW<br>FYG-FLUORESCENT YELLOW GREEN                                        |           |      |                |              |            |        |            |        |                     |                       |             |      |                         |           | "SHSM"-STANDARD HIGHWAY<br>SIGNS AND MARKINGS BOOK |       |                                                    |                                                       |                      |      |                                  |                     |
|                        |           | AB                      | D3-1      | 42         | 12          |                         | 11/21/17  | 3.50      |      |                |              |            |        |            | 1      |                     | 12'-6"<br>X           |             |      |                         |           |                                                    |       | INSTALL INDEPENTENTLY ON<br>STOP SIGN SIDE OF ROAD |                                                       | 8                    |      |                                  |                     |
| NB                     | 3.565     | A                       | R2-1      |            |             |                         |  11/21/17   |           |      |                |              | 1          |        | X          |        |                     |                       |             |      |                         |           |                                                    |       |                                                    |                                                       |                      |      |                                  |                     |
|                        |           | A                       | R2-1      | 24         | 30          |                         |                                                                                              | 5.00      |      |                |              |            |        |            | 1      |                     | 14'-3"<br>X           |             |      |                         |           |                                                    |       |                                                    | X                                                     |                      |      |                                  |                     |
| NB                     | 3.595     | AB                      |           |            |             |                         | CENTRAL PARK HISTORIC SIGN                                                                   |           |      | 1              |              |            |        | X          |        |                     |                       |             |      |                         |           |                                                    |       |                                                    |                                                       |                      |      |                                  |                     |
| NB                     | 3.725     | A                       | W1-1R     |            |             |                         | RIGHT TURN                                                                                   |           |      |                |              | 1          |        | X          |        |                     |                       |             |      |                         |           |                                                    |       |                                                    |                                                       |                      |      |                                  |                     |
|                        |           | A                       | W13-1P    |            |             |                         |  11/21/17  |           |      |                |              | 1          |        |            |        |                     |                       |             |      |                         |           |                                                    |       |                                                    |                                                       |                      |      |                                  |                     |
|                        |           | A                       |           | 36         | 36          | FY                      |                                                                                              | 9.00      |      |                |              |            |        |            | 2      |                     | 16'-3"<br>16'-0"<br>X |             |      |                         |           |                                                    |       |                                                    |                                                       | 2                    |      |                                  |                     |
|                        |           | A                       | W13-1P    | 24         | 24          | FY                      |           | 4.00      |      |                |              |            |        |            |        |                     |                       |             |      |                         |           |                                                    |       | INSTALL ON LEFT POST                               | X                                                     |                      |      |                                  |                     |
| NB                     | 3.865     | AB                      |           |            |             |                         | TOWN BROOK                                                                                   |           |      | 1              |              |            |        | X          |        |                     |                       |             |      |                         |           |                                                    |       |                                                    |                                                       |                      |      |                                  |                     |
| NB                     | 3.870     | A                       | VD-701    |            |             |                         |  4/9/18   |           |      |                |              | 1          |        | X          |        |                     |                       |             |      |                         |           |                                                    |       |                                                    |                                                       |                      |      |                                  |                     |
|                        |           | A                       | VD-701    | 6          | 10          |                         |                                                                                              | 0.42      |      |                |              |            |        |            | 1      |                     | 7'-3"<br>X            |             |      |                         |           |                                                    |       |                                                    |                                                       |                      | T-42 |                                  |                     |
| NB                     | 3.878     | A                       |           |            |             |                         | LEFT TURN ONLY AT<br>BREAK IN CENTER LINE                                                    |           |      |                |              | 1          |        | X          |        |                     |                       |             |      |                         |           |                                                    |       |                                                    |                                                       |                      |      |                                  |                     |
|                        |           | A                       | W16-18P   | 24         | 12          | FY                      |  11/21/17 | 2.00      |      |                |              |            |        |            | 1      |                     |                       | 18'-0"<br>X |      |                         |           |                                                    |       |                                                    | INSTALL NEW POST IN SAME<br>LOCATION BEHIND GUARDRAIL |                      | 4    |                                  |                     |
|                        |           | A                       |           | 30         | 36          |                         |                                                                                              | 7.50      |      |                |              |            |        |            |        |                     |                       |             |      |                         |           |                                                    |       |                                                    |                                                       | 4                    |      |                                  |                     |
|                        |           | SIGN SUMMARY SHEET     |           |                         |           |            |             | SHEET TOTALS            |                                                                                              | 31.42     | 0.00 | 2              | 0            | 0          | 5      | 0          | 0      | 6                   |                       | 85.0        | 0    | 0.0                     | 0.0       | 0.0                                                | 0.0   | PROJECT NAME: STATEWIDE-SOUTH REGION               | PROJECT NUMBER: STPG SIGN(57)                         |                      |      | VERMONT AGENCY OF TRANSPORTATION |                     |
|                        |           |                         |           |            |             |                         |                                                                                              | SF        | SF   | EA             | EA           | EA         | EA     | EA         | EA     | EA                  |                       | FT          |      | EA                      | LB        | LB                                                 | LB    | LB                                                 |                                                       |                      |      |                                  |                     |
|                        |           |                         |           |            |             | TOWN DIRECTIONAL TOTALS |                                                                                              | 615.1     | 0.0  | 21             | 16           | 16         | 132    | 0          | 0      | 110                 |                       | 1630.0      | 0    | 0.0                     |           |                                                    |       | FILE NAME: z16t041Vernon142 NB.xls                 | PLOT DATE: 2/27/2017                                  |                      |      |                                  |                     |
|                        |           PROJECT MANAGER: D. MUNRO                          |                                                       | DRAWN BY: W. GORDON  |      |                                  |                     |
|                        |           DESIGNED BY: P. MCKECHNIE                          |                                                       | CHECKED: BRZEZOWSKI  |      |                                  |                     |
|                        |           VERNON VT-142 NB 10                                |                                                       | SHEET 158 OF 264     |      |                                  |                     |