




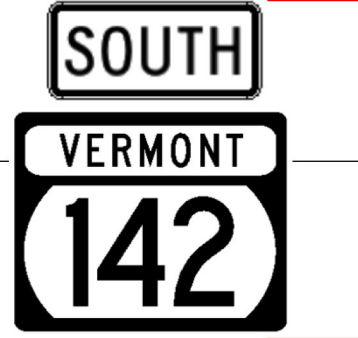

DIRECTION	MILEPOINT	LOCATION CODE (SHEET 4)	SIGN CODE	WIDTH (IN)	HEIGHT (IN)	SHEETING REMARKS	SIGN LEGEND	NEW SIGNS		EXISTING SIGNS			EXIST POST		NUMBER OF NEW POSTS	SQUARE STEEL (IN)			TUBULAR STEEL Ø (IN)				SIGN FRAME REQUIRED	REMARKS	SIGN DETAIL LOCATION				
								"A"	"B"	RETAIN	SALVAGE FROM	SALVAGE TO	REMOVE	RETAIN		REMOVE	1.75	2.00	2.50	FOUNDATION	3.00	3.50			4.00	5.00	SHSM	SIGN DETAILS SHEET #	STANDARD SHEET #
																	(LB / FT)				(LB / FT)								
<b>SB VERNON VT ROUTE 142</b>							FY-FLUORESCENT YELLOW FYG-FLUORESCENT YELLOW GREEN															"SHSM"-STANDARD HIGHWAY SIGNS AND MARKINGS BOOK							
		F	M3-3	24	12		 11/14/17	2.00							1	13'-0" X							SOUTH, GREEN ON WHITE	X					
		F	VM1-5	30	24			5.00																			E-136		
SB	8.010	F	R2-1				 11/14/17																						
		F	R2-1	24	30			5.00							1	12'-3" X									X				
SB	7.550	F	R2-1																					SPEED LIMIT 50					
SB	7.188	F	R2-1				 11/14/17																						
		F	R2-1	24	30			5.00							1	13'-9" X									X				
SB	6.850	F	M3-3																					SOUTH					
		F	M1-5																					142					
SB	6.775	F	R2-1																					SPEED LIMIT 50					
SB	6.715	F	VW-619				 11/15/17																						
		F	VW-619	30	30			6.25							1	16'-0" X											T-82		
SB	6.220	F																						HISTORIC SITE MARKER AHEAD					
SB	6.185	F	VW-202				 11/15/17																						
		F	VW-202	30	30			6.25							1	15'-0" X											T-81		
<b>SIGN SUMMARY SHEET</b>							<b>SHEET TOTALS</b>	29.50	0.00	0	0	0	9	0	0	5	75.0	0	0.0	0.0	0.0	0.0				PROJECT NAME: STATEWIDE-SOUTH REGION PROJECT NUMBER: STPG SIGN(57)			
								SF	SF	EA	EA	EA	EA	EA	EA	EA	FT	EA	LB	LB	LB	LB				FILE NAME: z16t041Vernon142 SB.xls PROJECT MANAGER: D. MUNRO DESIGNED BY: P. MCKECHNIE VERNON VT-142 SB 3			
VERMONT AGENCY OF TRANSPORTATION							<b>TOWN DIRECTIONAL TOTALS</b>	485.1	0.0	14	12	12	104	0	0	88	1310.0	0		0.0						PLOT DATE: 2/27/2017 DRAWN BY: W. GORDON CHECKED: BRZEZOWSKA SHEET 171 OF 264			