



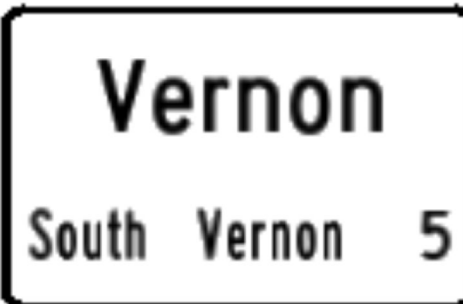



DIRECTION	MILEPOINT	LOCATION CODE (SHEET 4)	SIGN CODE	WIDTH (IN)	HEIGHT (IN)	SHEETING REMARKS	SIGN LEGEND	NEW SIGNS		EXISTING SIGNS				EXIST POST		NUMBER OF NEW POSTS	SQUARE STEEL (IN)			TUBULAR STEEL Ø (IN)				SIGN FRAME REQUIRED	REMARKS	SIGN DETAIL LOCATION			
								"A"	"B"	RETAIN	SALVAGE FROM	SALVAGE TO	REMOVE	RETAIN	REMOVE		1.75	2.00	2.50	FOUNDATION	3.00	3.50	4.00			5.00	SHSM	SIGN DETAILS SHEET #	STANDARD SHEET #
																	(LB / FT)				(LB / FT)								
SB VERNON VT ROUTE 142							FY-FLUORESCENT YELLOW FYG-FLUORESCENT YELLOW GREEN															"SHSM"-STANDARD HIGHWAY SIGNS AND MARKINGS BOOK							
SB	5.515	F	W10-1				 11/15/17																						
		F	W10-1	36	36			7.07																		36" DIAMETER INSTALL ON RETAINED POST	X		
SB	5.470	F	W1-10b																										
		F	W13-1P				 11/15/17																						
		F	W1-10b	36	36			9.00																					
		F	W13-1P	24	24			4.00																		INSTALL ON LEFT POST	X		
SB	5.405	F	R15-1				RAILROAD CROSS BUCK (ON MAST ARM)			1																			
SB	5.320	F	M3-3	24	12		 11/15/17	2.00																		INSTALL ±420' UPSTATION FROM SIGN AT MP 5.240 SB SOUTH, GREEN ON WHITE	X		
		F	VM1-5	30	24			5.00																					
SB	5.240	F	M3-3				SOUTH																						
		F	VM1-5				VERMONT 142																						
		F	VD-018A	36	24		 11/15/17	6.00																		INSTALL IN SAME LOCATION AS EXISTING ROUTE MARKER SIGN			
SB	5.155	FE	D3-1				PECK RD PVT																						
SB	5.130	FE	D3-1	42	12		 11/15/17	3.50																		INSTALL MINIMUM 10' FROM UTILITY POLE ON SOUTH SIDE OF INTERSECTION		8	
SB	5.155	G	R1-1				STOP			1																			
SIGN SUMMARY SHEET							SHEET TOTALS	36.57	0.00	2	0	0	6	0	0	5	75.0	0	0.0	0.0	0.0	0.0	PROJECT NAME: STATEWIDE-SOUTH REGION PROJECT NUMBER: STPG SIGN(57)						
VERMONT AGENCY OF TRANSPORTATION							TOWN DIRECTIONAL TOTALS	485.1	0.0	14	12	12	104	0	0	88	1310.0	0		0.0				FILE NAME: z16t041Vernon142 SB.xls PROJECT MANAGER: D. MUNRO DESIGNED BY: P. MCKECHNIE VERNON VT-142 SB 5	PLOT DATE: 2/27/2017 DRAWN BY: W. GORDON CHECKED: BRZEZOWSK SHEET 173 OF 264				