
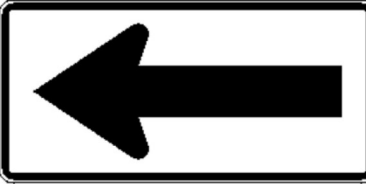





DIRECTION	MILEPOINT	LOCATION CODE (SHEET 4)	SIGN CODE	WIDTH (IN)	HEIGHT (IN)	SHEETING REMARKS	SIGN LEGEND	NEW SIGNS		EXISTING SIGNS			EXIST POST		NUMBER OF NEW POSTS	SQUARE STEEL (IN)			TUBULAR STEEL Ø (IN)				SIGN FRAME REQUIRED	REMARKS	SIGN DETAIL LOCATION				
								"A"	"B"	RETAIN	SALVAGE FROM	SALVAGE TO	REMOVE	RETAIN		REMOVE	1.75	2.00	2.50	FOUNDATION	3.00	3.50			4.00	5.00	SHSM	SIGN DETAILS SHEET #	STANDARD SHEET #
																	(LB / FT)				(LB / FT)								
SB VERNON VT ROUTE 142							FY-FLUORESCENT YELLOW FYG-FLUORESCENT YELLOW GREEN															"SHSM"-STANDARD HIGHWAY SIGNS AND MARKINGS BOOK							
		G	VD-700				MILE MARKER 1420 / 1318 / 0393			1	1													SALVAGE MILE MARKER BACK TO BACK WITH PROPOSED STOP SIGN AT SAME LOCATION					
		H	R1-1	36	36		 11/20/17	9.00																	X				
		G	VD-700				MILE MARKER 1420 / 1318 / 0393				1																		
SB	3.880	F	W1-6L				 11/20/17					1																	
		F	W1-6L	48	24	FY		8.00																		X			
SB	3.860	F	M3-3									1																	
		F	VM1-5									1																	
		F	M3-3	24	12		 11/20/17	2.00																		X			
		F	VM1-5	30	24			5.00																			E-136		
SB	3.825	E	W1-6R				 11/20/17					1	X	X															
		E	W1-6R	48	24	FY		8.00																		X			
SB	3.735	F	R2-1				 11/20/17					1																	
		F	R2-1	24	30			5.00																		X			
SB	3.470	FE	D3-1				PVT T Bird Dr			1				X															
SB	3.427	F	W11-8				EMERGENCY VEHICLES					1			X														
SIGN SUMMARY SHEET							SHEET TOTALS	37.00	0.00	1	1	1	7	0	0	6	90.0	0	0.0	0.0	0.0	0.0	0.0	0.0	PROJECT NAME: STATEWIDE-SOUTH REGION PROJECT NUMBER: STPG SIGN(57)				
VERMONT AGENCY OF TRANSPORTATION							TOWN DIRECTIONAL TOTALS	485.1	0.0	14	12	12	104	0	0	88	1310.0	0		0.0					FILE NAME: z16t041Vernon142 SB.xls PROJECT MANAGER: D. MUNRO DESIGNED BY: P. MCKECHNIE VERNON VT-142 SB 8	PLOT DATE: 2/27/2017 DRAWN BY: W. GORDON CHECKED: BRZEZOWSK SHEET 176 OF 264			