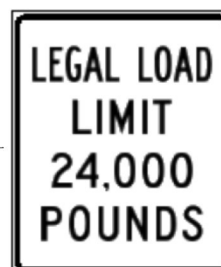


DIRECTION	MILEPOINT	LOCATION CODE (SHEET 4)	SIGN CODE	WIDTH (IN)	HEIGHT (IN)	SHEETING REMARKS	SIGN LEGEND	NEW SIGNS		EXISTING SIGNS				EXIST POST		NUMBER OF NEW POSTS	SQUARE STEEL (IN)			TUBULAR STEEL Ø (IN)				SIGN FRAME REQUIRED	REMARKS	SIGN DETAIL LOCATION																		
								"A"	"B"	RETAIN	SALVAGE FROM	SALVAGE TO	REMOVE	RETAIN	REMOVE		1.75	2.00	2.50	FOUNDATION	3.00	3.50	4.00			5.00	SHSM	SIGN DETAILS SHEET #	STANDARD SHEET #															
																	(LB / FT)				(LB / FT)																							
																	1.88	2.42	3.35		7.60	9.00	10.80			14.60																		
SB VERNON VT ROUTE 142							FY-FLUORESCENT YELLOW FYG-FLUORESCENT YELLOW GREEN															"SHSM"-STANDARD HIGHWAY SIGNS AND MARKINGS BOOK																						
SB	0.983	FE	D3-1				VALLEY VIEW DR																																					
		H	R1-1				STOP																																					
		G	VD-700				MILE MARKER 1420 / 1318 / 0100																																					
		H	R1-1	30	30		11/15/17	6.25							1			13'-3" X						X																				
		G	VD-700	6	10		MILE MARKER 1420 / 1318 / 0100	0.42																	INSTALL SALVAGED SIGN BACK TO BACK ON STOP SIGN POST																			
SB	0.918	F	W11-5																																									
		F	W7-3aP																																									
		F	W11-5	30	30		11/15/17	6.25							1			13'-0" X						X																				
		F	W7-3aP	24	18			3.00																X																				
SB	0.809	G	VR-017					4/9/18																																				
		G	VR-017	24	30			5.00							1			14'-6" X							T-70																			
SB	0.795	FE	D3-1				Pond Rd																																					
		H	R1-1					11/14/17																																				
		H	R1-1	30	30			6.25																X																				
SB	0.770	F	W11-7				EQUESTRIAN TRAFFIC																																					
SIGN SUMMARY SHEET							SHEET TOTALS										27.17	0.00	1	1	1	8	0	0	3	45.0			0	0.0	0.0	0.0	PROJECT NAME: STATEWIDE-SOUTH REGION											
																	SF	SF	EA	EA	EA	EA	EA	EA	EA		FT		EA	LB	LB	LB	LB	PROJECT NUMBER: STPG SIGN(57)										
																																							FILE NAME: z16t041Vernon142 SB.xls	PLOT DATE: 2/27/2017				
							VERMONT AGENCY OF TRANSPORTATION										TOWN DIRECTIONAL TOTALS										485.1	0.0	14	12	12	104	0	0	88	1310.0			0	0.0			PROJECT MANAGER: D. MUNRO	DRAWN BY: W. GORDON
																																							DESIGNED BY: P. MCKECHNIE			CHECKED: BRZEZOWSKI		
																																							VERNON VT-142 SB 13			SHEET 181 OF 264		