


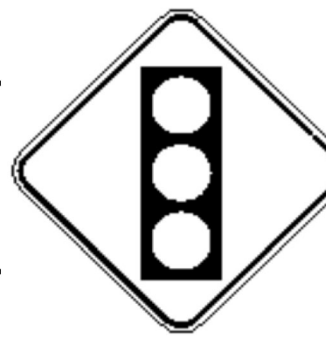


DIRECTION	MILEPOINT	LOCATION CODE (SHEET 4)	SIGN CODE	WIDTH (IN)	HEIGHT (IN)	SHEETING REMARKS	SIGN LEGEND	NEW SIGNS		EXISTING SIGNS				EXIST POST		NUMBER OF NEW POSTS	SQUARE STEEL (IN)			TUBULAR STEEL Ø (IN)				SIGN FRAME REQUIRED	REMARKS	SIGN DETAIL LOCATION			
								"A"	"B"	RETAIN	SALVAGE FROM	SALVAGE TO	REMOVE	RETAIN	REMOVE		1.75	2.00	2.50	FOUNDATION	3.00	3.50	4.00			5.00	SHSM	SIGN DETAILS SHEET #	STANDARD SHEET #
																	(LB / FT)				(LB / FT)								
<b>NB BRATTLEBORO VT ROUTE 142</b>							FY-FLUORESCENT YELLOW FYG-FLUORESCENT YELLOW GREEN															"SHSM"-STANDARD HIGHWAY SIGNS AND MARKINGS BOOK							
NB	1.100	A	VR-038				STATE HIGHWAY ENDS																						
		A	R2-1				SPEED LIMIT 25																						
		A	VD-700				MILE MARKER 1420 / 1318 / 0110				1																		
		A	VR-038	24	18		   LATE 2017	3.00																				T-71	
		A	R2-1	30	36			7.50																			X		
		A	VD-700				MILE MARKER 1420 / 1318 / 0110				1																		
NB	1.243	A	M3-1				NORTH																						
		A	VM5-1				VERMONT 142																						
NB	1.540	A	W3-3	30	30		 11/8/17	6.25																			X		
NB	1.642	C	R1-1				STOP				1																		
		C					PRIVATE RAILROAD CROSSING NO TRESPASSING				1																		
<b>SIGN SUMMARY SHEET</b>							SHEET TOTALS	16.75	0.00	2	1	1	5	0	0	2	30.0	0	0.0	0.0	0.0	0.0	PROJECT NAME: STATEWIDE-SOUTH REGION PROJECT NUMBER: STPG SIGN(57)						
VERMONT AGENCY OF TRANSPORTATION							TOWN DIRECTIONAL TOTALS	209.8	0.0	7	4	4	50	0	0	30	420.0	2	236.0				FILE NAME: z16t041Brattleboro142 NB.xls PROJECT MANAGER: D. MUNRO DESIGNED BY: P. MCKECHNIE BRATTLEBORO VT-142 NB 4	PLOT DATE: 2/27/2017 DRAWN BY: W. GORDON CHECKED: BRZEZOWSK SHEET 187 OF 264					