





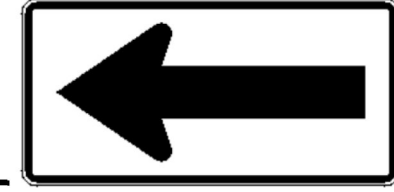
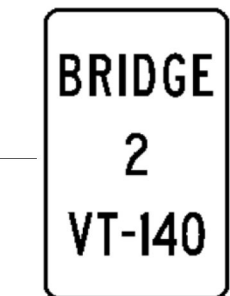




| DIRECTION                        | MILEPOINT | LOCATION CODE (SHEET 4) | SIGN CODE | WIDTH (IN) | HEIGHT (IN) | SHEETING REMARKS | SIGN LEGEND                                                                                  | NEW SIGNS |      | EXISTING SIGNS |              |            | EXIST POST |        | NUMBER OF NEW POSTS | SQUARE STEEL (IN) |           |      | TUBULAR STEEL Ø (IN) |            |                           |                                                 | SIGN FRAME REQUIRED                  | REMARKS | SIGN DETAIL LOCATION |      |      |                                                                       |                  |
|----------------------------------|-----------|-------------------------|-----------|------------|-------------|------------------|----------------------------------------------------------------------------------------------|-----------|------|----------------|--------------|------------|------------|--------|---------------------|-------------------|-----------|------|----------------------|------------|---------------------------|-------------------------------------------------|--------------------------------------|---------|----------------------|------|------|-----------------------------------------------------------------------|------------------|
|                                  |           |                         |           |            |             |                  |                                                                                              | "A"       | "B"  | RETAIN         | SALVAGE FROM | SALVAGE TO | REMOVE     | RETAIN |                     | REMOVE            | 1.75      | 2.00 | 2.50                 | FOUNDATION | 3.00                      | 3.50                                            |                                      |         | 4.00                 | 5.00 | SHSM | SIGN DETAILS SHEET #                                                  | STANDARD SHEET # |
|                                  |           |                         |           |            |             |                  |                                                                                              |           |      |                |              |            |            |        |                     |                   | (LB / FT) |      |                      |            | (LB / FT)                 |                                                 |                                      |         |                      |      |      |                                                                       |                  |
| <b>EB WALLINGFORD VT RTE 140</b> |           |                         |           |            |             |                  | FY-FLUORESCENT YELLOW<br>FYG-FLUORESCENT YELLOW GREEN                                        |           |      |                |              |            |            |        |                     |                   |           |      |                      |            |                           | "SHSM"-STANDARD HIGHWAY SIGNS AND MARKINGS BOOK |                                      |         |                      |      |      |                                                                       |                  |
|                                  |           | A                       | W7-3aP    |            |             |                  |  11/9/17    |           |      |                |              | 1          |            |        |                     |                   |           |      |                      |            |                           |                                                 |                                      |         |                      |      |      |                                                                       |                  |
|                                  |           | A                       | W1-5L     | 30         | 30          |                  |  11/20/17   | 6.25      |      |                |              |            |            |        | 1                   | 14'-0"            | X         |      |                      |            |                           |                                                 |                                      |         |                      | X    |      |                                                                       |                  |
|                                  |           | A                       | W7-3aP    | 24         | 18          |                  |                                                                                              | 3.00      |      |                |              |            |            |        |                     |                   |           |      |                      |            |                           |                                                 |                                      |         |                      | X    |      |                                                                       |                  |
| EB                               | 0.600     | A                       | R2-1      |            |             |                  |  10/20/17   |           |      |                |              | 1          | X          |        |                     |                   |           |      |                      |            |                           |                                                 |                                      |         |                      |      |      |                                                                       |                  |
|                                  |           | A                       | R2-1      | 24         | 30          |                  |                                                                                              | 5.00      |      |                |              |            |            |        |                     |                   |           |      |                      |            |                           |                                                 |                                      |         |                      | X    |      | INSTALL ON RETAINED POST                                              |                  |
| EB                               | 0.862     | A                       | W1-4R     | 30         | 30          |                  |  10/20/17   | 6.25      |      |                |              |            |            |        | 1                   | 14'-6"            | X         |      |                      |            |                           |                                                 |                                      |         |                      |      | X    | INSTALL SIGN ±355' UPSTATION FROM EXISTING MILE MARKER AT MP 0.795 EB |                  |
| EB                               | 1.050     | A                       | R2-1      |            |             |                  |  10/20/17 |           |      |                |              | 1          | X          |        |                     |                   |           |      |                      |            |                           |                                                 |                                      |         |                      |      |      |                                                                       |                  |
|                                  |           | A                       | R2-1      | 24         | 30          |                  |                                                                                              | 5.00      |      |                |              |            |            |        |                     |                   |           |      |                      |            |                           |                                                 |                                      |         |                      | X    |      | INSTALL ON RETAINED POST                                              |                  |
| EB                               | 1.095     | B                       | W1-6      |            |             |                  |  11/28/17 |           |      |                |              | 1          |            | X      |                     |                   |           |      |                      |            |                           |                                                 |                                      |         |                      |      |      |                                                                       |                  |
|                                  |           | B                       | W1-6      | 48         | 24          |                  |                                                                                              | 8.00      |      |                |              |            |            |        | 2                   | 14'-0"            | 13'-9"    | X    |                      |            |                           |                                                 |                                      |         |                      | X    |      |                                                                       |                  |
| EB                               | 1.111     | A                       | W1-6      | 48         | 24          |                  |  11/13/17 | 8.00      |      |                |              |            |            |        | 2                   | 13'-3"            | 12'-6"    | X    |                      |            |                           |                                                 |                                      |         |                      |      | X    | INSTALL SIGN ±85 UPSTATION FROM EXISTING SIGN AT MP 1.095 EB          |                  |
| EB                               | 1.310     | A                       | VD-701    |            |             |                  |  11/9/17  |           |      |                |              | 1          |            | X      |                     |                   |           |      |                      |            |                           |                                                 |                                      |         |                      |      |      |                                                                       |                  |
|                                  |           | A                       | VD-701    | 6          | 10          |                  |                                                                                              | 0.42      |      |                |              |            |            |        | 1                   | 7'-6"             | X         |      |                      |            |                           |                                                 |                                      |         |                      |      |      | T-42                                                                  |                  |
| EB                               | 1.345     | A                       | W1-3L     | 30         | 30          |                  |  4/9/18  | 6.25      |      |                |              |            |            |        | 1                   | 13'-6"            | X         |      |                      |            |                           |                                                 |                                      |         |                      |      | X    | INSTALL SIGN ±185' UPSTATION FROM BRIDGE PLAQUE AT MP 1.310 EB        |                  |
|                                  |           | A                       | W13-1P    | 18         | 18          |                  |          | 2.25      |      |                |              |            |            |        |                     |                   |           |      |                      |            |                           |                                                 |                                      |         |                      |      | X    |                                                                       |                  |
| <b>SIGN SUMMARY SHEET</b>        |           |                         |           |            |             |                  | <b>SHEET TOTALS</b>                                                                          | 50.42     | 0.00 | 0              | 0            | 0          | 5          | 0      | 0                   | 8                 | 115.0     | 0    | 0.0                  | 0.0        | 0.0                       | 0.0                                             | PROJECT NAME: STATEWIDE-SOUTH REGION |         |                      |      |      |                                                                       |                  |
|                                  |           |                         |           |            |             |                  | SF                                                                                           | SF        | EA   | EA             | EA           | EA         | EA         | EA     | EA                  | EA                | EA        | EA   | EA                   | EA         | EA                        | EA                                              | PROJECT NUMBER: STPG SIGN(57)        |         |                      |      |      |                                                                       |                  |
| VERMONT AGENCY OF TRANSPORTATION |           |                         |           |            |             |                  | <b>TOWN DIRECTIONAL TOTALS</b>                                                               | 489.4     | 0.0  | 46             | 4            | 4          | 100        | 0      | 0                   | 86                | 1250.0    | 0    |                      | 0.0        |                           | FILE NAME: z16t041Wallinaford140EB.xls          | PLOT DATE: 2/27/2017                 |         |                      |      |      |                                                                       |                  |
|                                  |           DESIGNED BY: P. MCKECHNIE | CHECKED: BRZEZOWSK                              |                                      |         |                      |      |      |                                                                       |                  |
|                                  |           WALLINGFORD VT-140 EB 4   | SHEET 200                                       | OF                                   | 264     |                      |      |      |                                                                       |                  |