




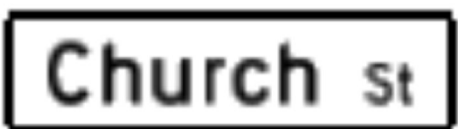


DIRECTION	MILEPOINT	LOCATION CODE (SHEET 4)	SIGN CODE	WIDTH (IN)	HEIGHT (IN)	SHEETING REMARKS	SIGN LEGEND	NEW SIGNS		EXISTING SIGNS			EXIST POST		NUMBER OF NEW POSTS	SQUARE STEEL (IN)			TUBULAR STEEL Ø (IN)				SIGN FRAME REQUIRED	REMARKS	SIGN DETAIL LOCATION				
								"A"	"B"	RETAIN	SALVAGE FROM	SALVAGE TO	REMOVE	RETAIN		REMOVE	1.75	2.00	2.50	FOUNDATION	3.00	3.50			4.00	5.00	SHSM	SIGN DETAILS SHEET #	STANDARD SHEET #
																	(LB / FT)				(LB / FT)								
EB WALLINGFORD VT RTE 140							FY-FLUORESCENT YELLOW FYG-FLUORESCENT YELLOW GREEN															"SHSM"-STANDARD HIGHWAY SIGNS AND MARKINGS BOOK							
EB	1.587	AB	D3-1				 Church st 11/9/17																CHURCH ST (TH-17)						
		AB	D3-1	42	12			3.50							1	9'-9"	X							9					
EB	1.589	D	VR-017				LLL 24,000 LBS																						
		D	VD-700				MILE MARKER 1400 / 1125 / 0161																SALVAGE TO NEW POST ASSEMBLY AT MP 1.599 EB						
		C	VR-017	24	30		 LEGAL LOAD LIMIT 24,000 POUNDS 11/27/17	5.00							1	12'-6"	X								T-70				
EB	1.599	D	R1-1				STOP																						
		D	R1-1	30	30		 STOP 10/20/17	6.25							1	8'-3"	X						INSTALL ON RETAINED POST	X					
		C	VD-700				MILE MARKER 1400 / 1125 / 0161																INSTALL SALVAGED MILE MARKER BACK TO BACK ON RETAINED STOP SIGN POST						
EB	1.642	A	R2-1	24	30		 SPEED LIMIT 40 11/27/17	5.00															INSTALL SIGN ±440' DOWNSTATION FROM EXISTING SIGN AT MP 1.725 EB	X					
EB	1.725	A	R2-1				SPEED LIMIT 40																						
EB	1.778	A	W1-6				 11/13/17																						
		A	W1-6	48	24			8.00							2	12'-3"	12'-0"	X						X					
EB	1.781	B	W1-6				 11/13/17																						
		B	W1-6	48	24			8.00															INSTALL ON RETAINED POSTS	X					
EB	1.835	A	VD-062A				OFFICIAL BUSINESS DIRECTIONAL SIGN																White Rocks Recreation Area						
SIGN SUMMARY SHEET							SHEET TOTALS	35.75	0.00	1	1	1	7	0	0	5	75.0	0	0.0	0.0	0.0	0.0	PROJECT NAME: STATEWIDE-SOUTH REGION PROJECT NUMBER: STPG SIGN(57)						
VERMONT AGENCY OF TRANSPORTATION							TOWN DIRECTIONAL TOTALS	489.4	0.0	46	4	4	100	0	0	86	1250.0	0		0.0			FILE NAME: z16t041Wallinaford140EB.xls PROJECT MANAGER: D. MUNRO DESIGNED BY: P. MCKECHNIE WALLINGFORD VT-140 EB 5	PLOT DATE: 2/27/2017 DRAWN BY: W. GORDON CHECKED: BRZEZOWSK SHEET 201 OF 264					